

RECEIVED
21 DEC. 83
LONDON

Dr. to Bal.

16/3/83

1/5/83.


Mudship Section of No 19 S.S. - "River Garry"
 To Class 100 A.1. - Belfast Report No. 300¹⁰
 Scale $\frac{1}{2}$ inch = one foot. -

Proportions 7. 2 Breadths
12. 0 Depth to Main Sk.

Humeralals

$\frac{1}{2}$ Breadth	16.5
$\frac{1}{2}$ Girth	32.72
Depth	<u>19.73</u>

$$\begin{array}{r} 68.95 \times 238.3 = 16430.7 \text{ Scantling lbs.} \\ + 1/10^{\text{th}} = 1643.0 \\ \hline 18073.7 \text{ Equipment lbs.} \end{array}$$

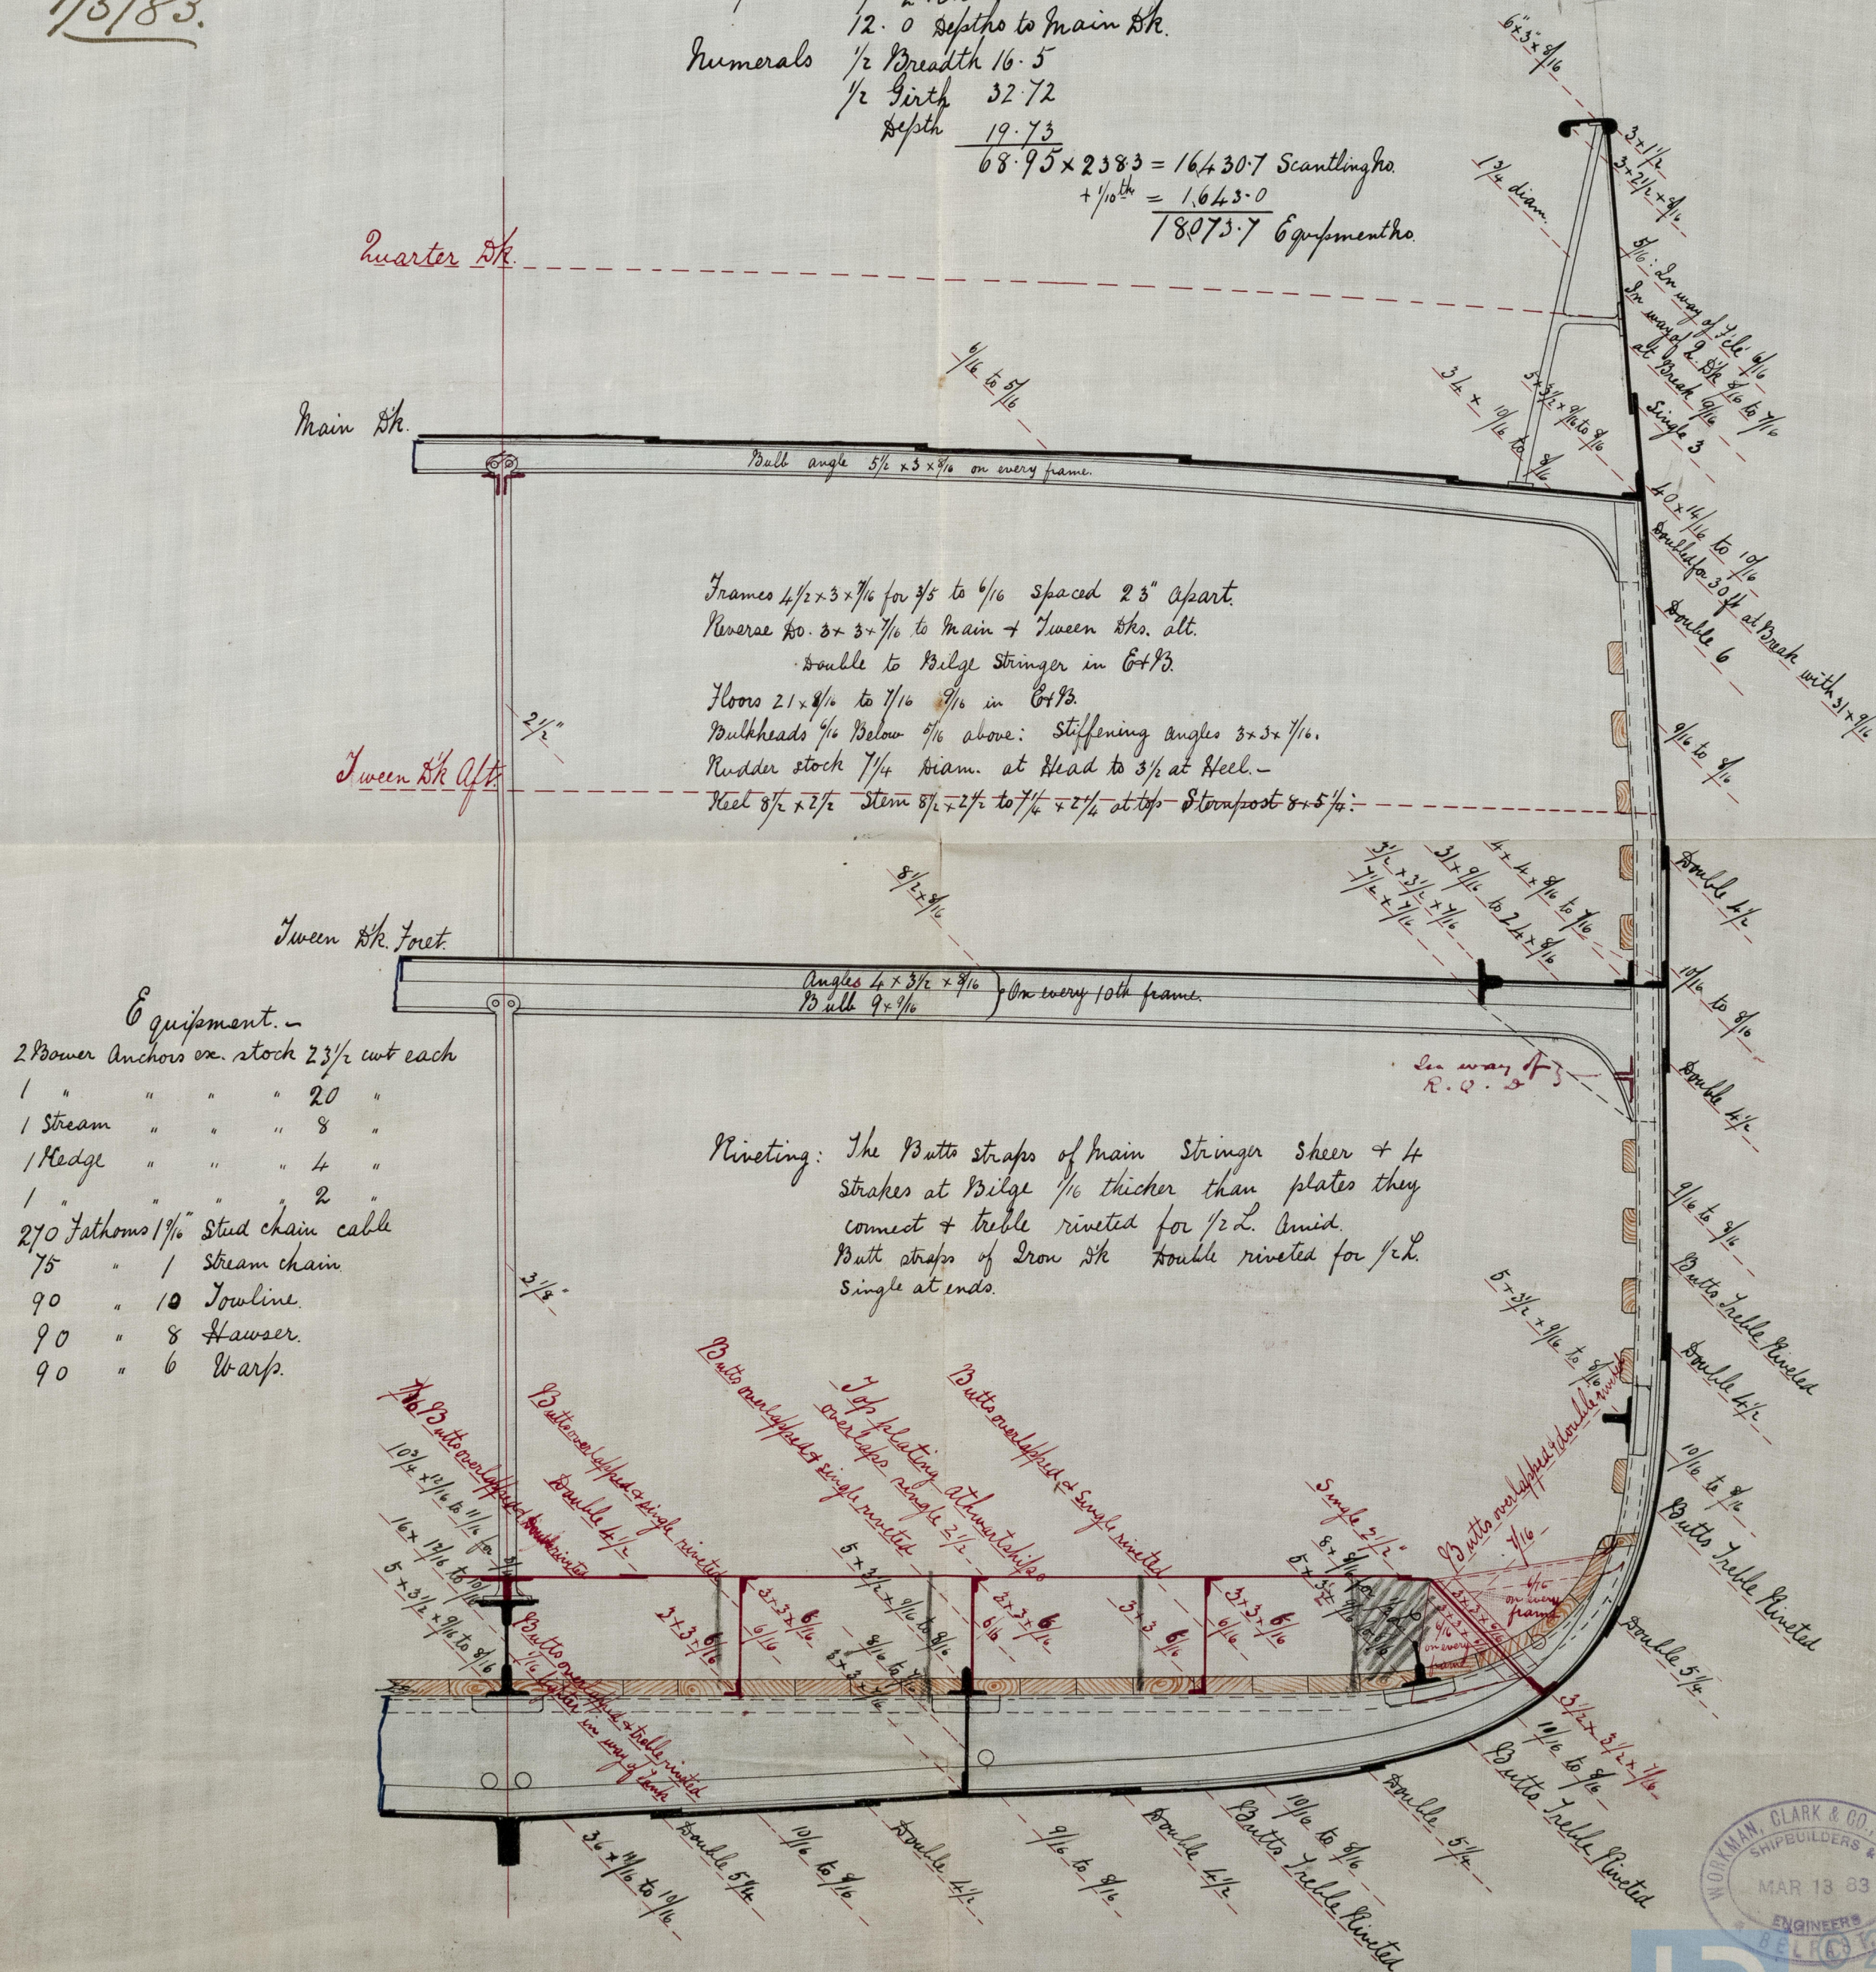

Equipment. —

2	Power Anchors ex. stock	23 1/2	cwt each
1	"	"	"
1	"	"	"
1	Stream	"	"
1	Hedge	"	"
1	"	"	"
270	Fathoms 1/4" Stud chain		cable
75	"	1	Stream chain.
90	"	10	Towline.
90	"	8	Hawser.
90	"	6	Warps.

Riveting: The Butts straps of main stringer sheer + 4
strakes at Bridge $\frac{1}{8}$ thicker than plates they
connect + treble riveted for $\frac{1}{2}$ L. Amid.
Butt straps of Iron Sk double riveted for $\frac{1}{2}$ L.
single at ends.

