


Ltr. to Bel.
 16/3/83.
11/5/83.

Longitudinal Section of No. 19 S.S. — "River Garry"
To class 100 A. 1. — Belfast Report No. 300¹⁰~~8~~
Scale $\frac{1}{8}$ inch = one foot. —

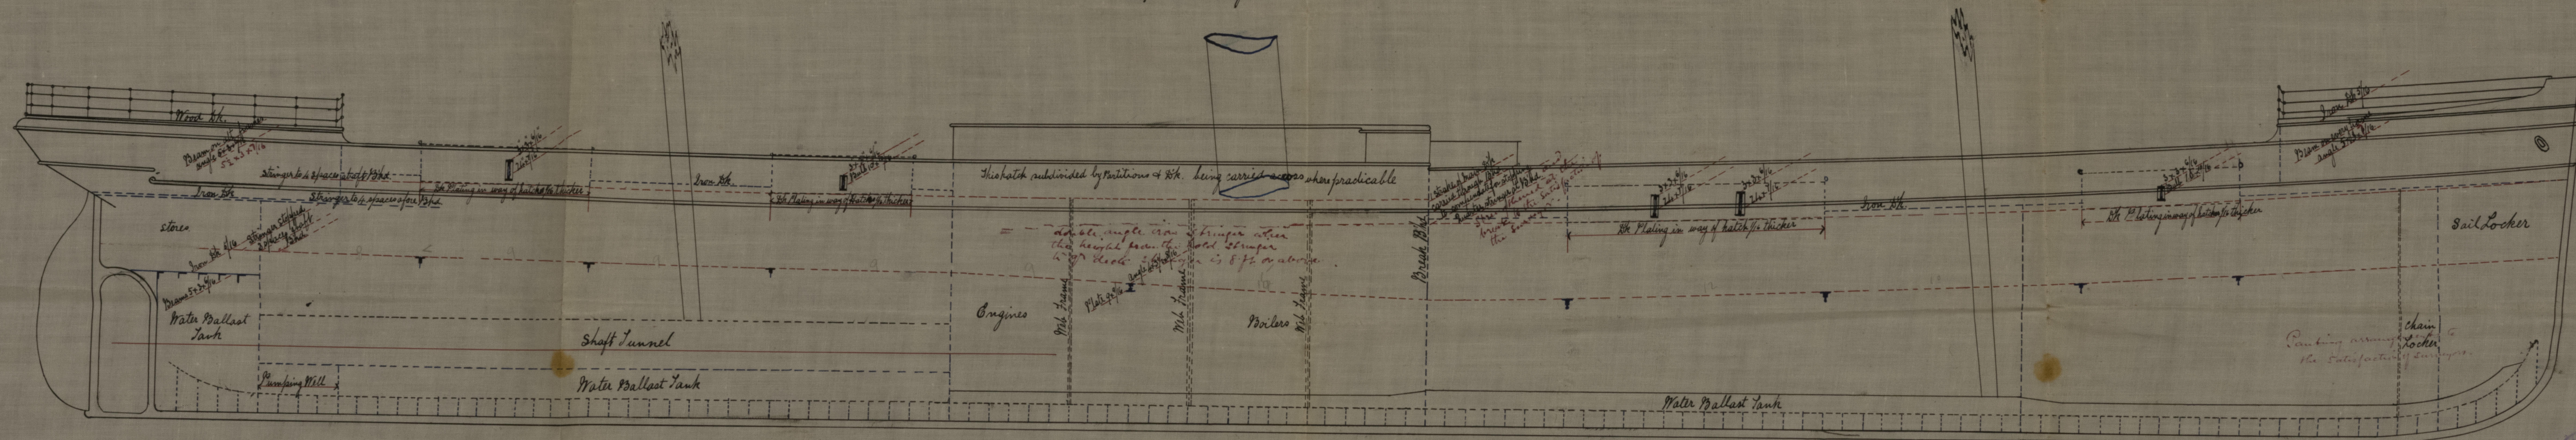

J. E.
13. 3. 83

16/3/83