

LOYD'S REGISTER OF SHIPPING
RECEIVED
21 DEC. 83
LONDON


Proposed alterations of Sheer Shake

Dec. 19 8. 8. —

Scale $\frac{1}{2}$ inch = one foot. —

Dr: to Bel:
1/5/83

River Garry
Belfast Report
No. 3009

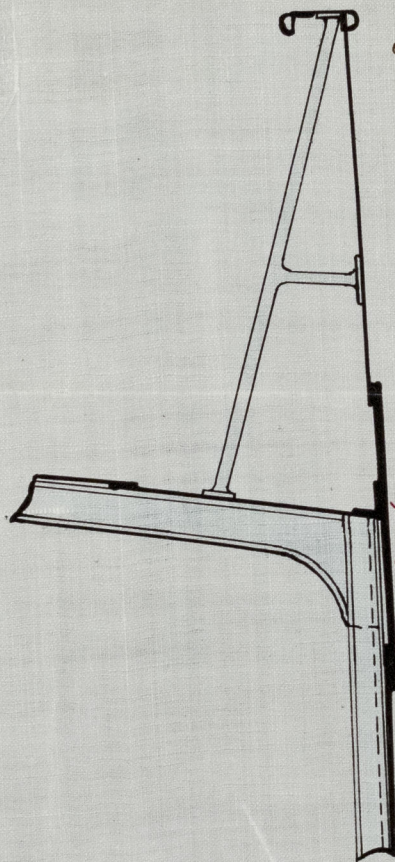

40 x 15/16 in 12/16
built for 30 feet truck with 31 x 9/16.

WORKMAN, CLARK & CO., LIMITED
SHIPBUILDERS &
APR 27 83
ENGINEERS
BELFAST.

J. H. L.
1/5/83

J. H. L.
20.4.83

Lloyd's Register
Foundation