


To Class 100 A.1.

Scale $\frac{1}{2}$ = one foot.

Dr. to Bal.
19/8/83.

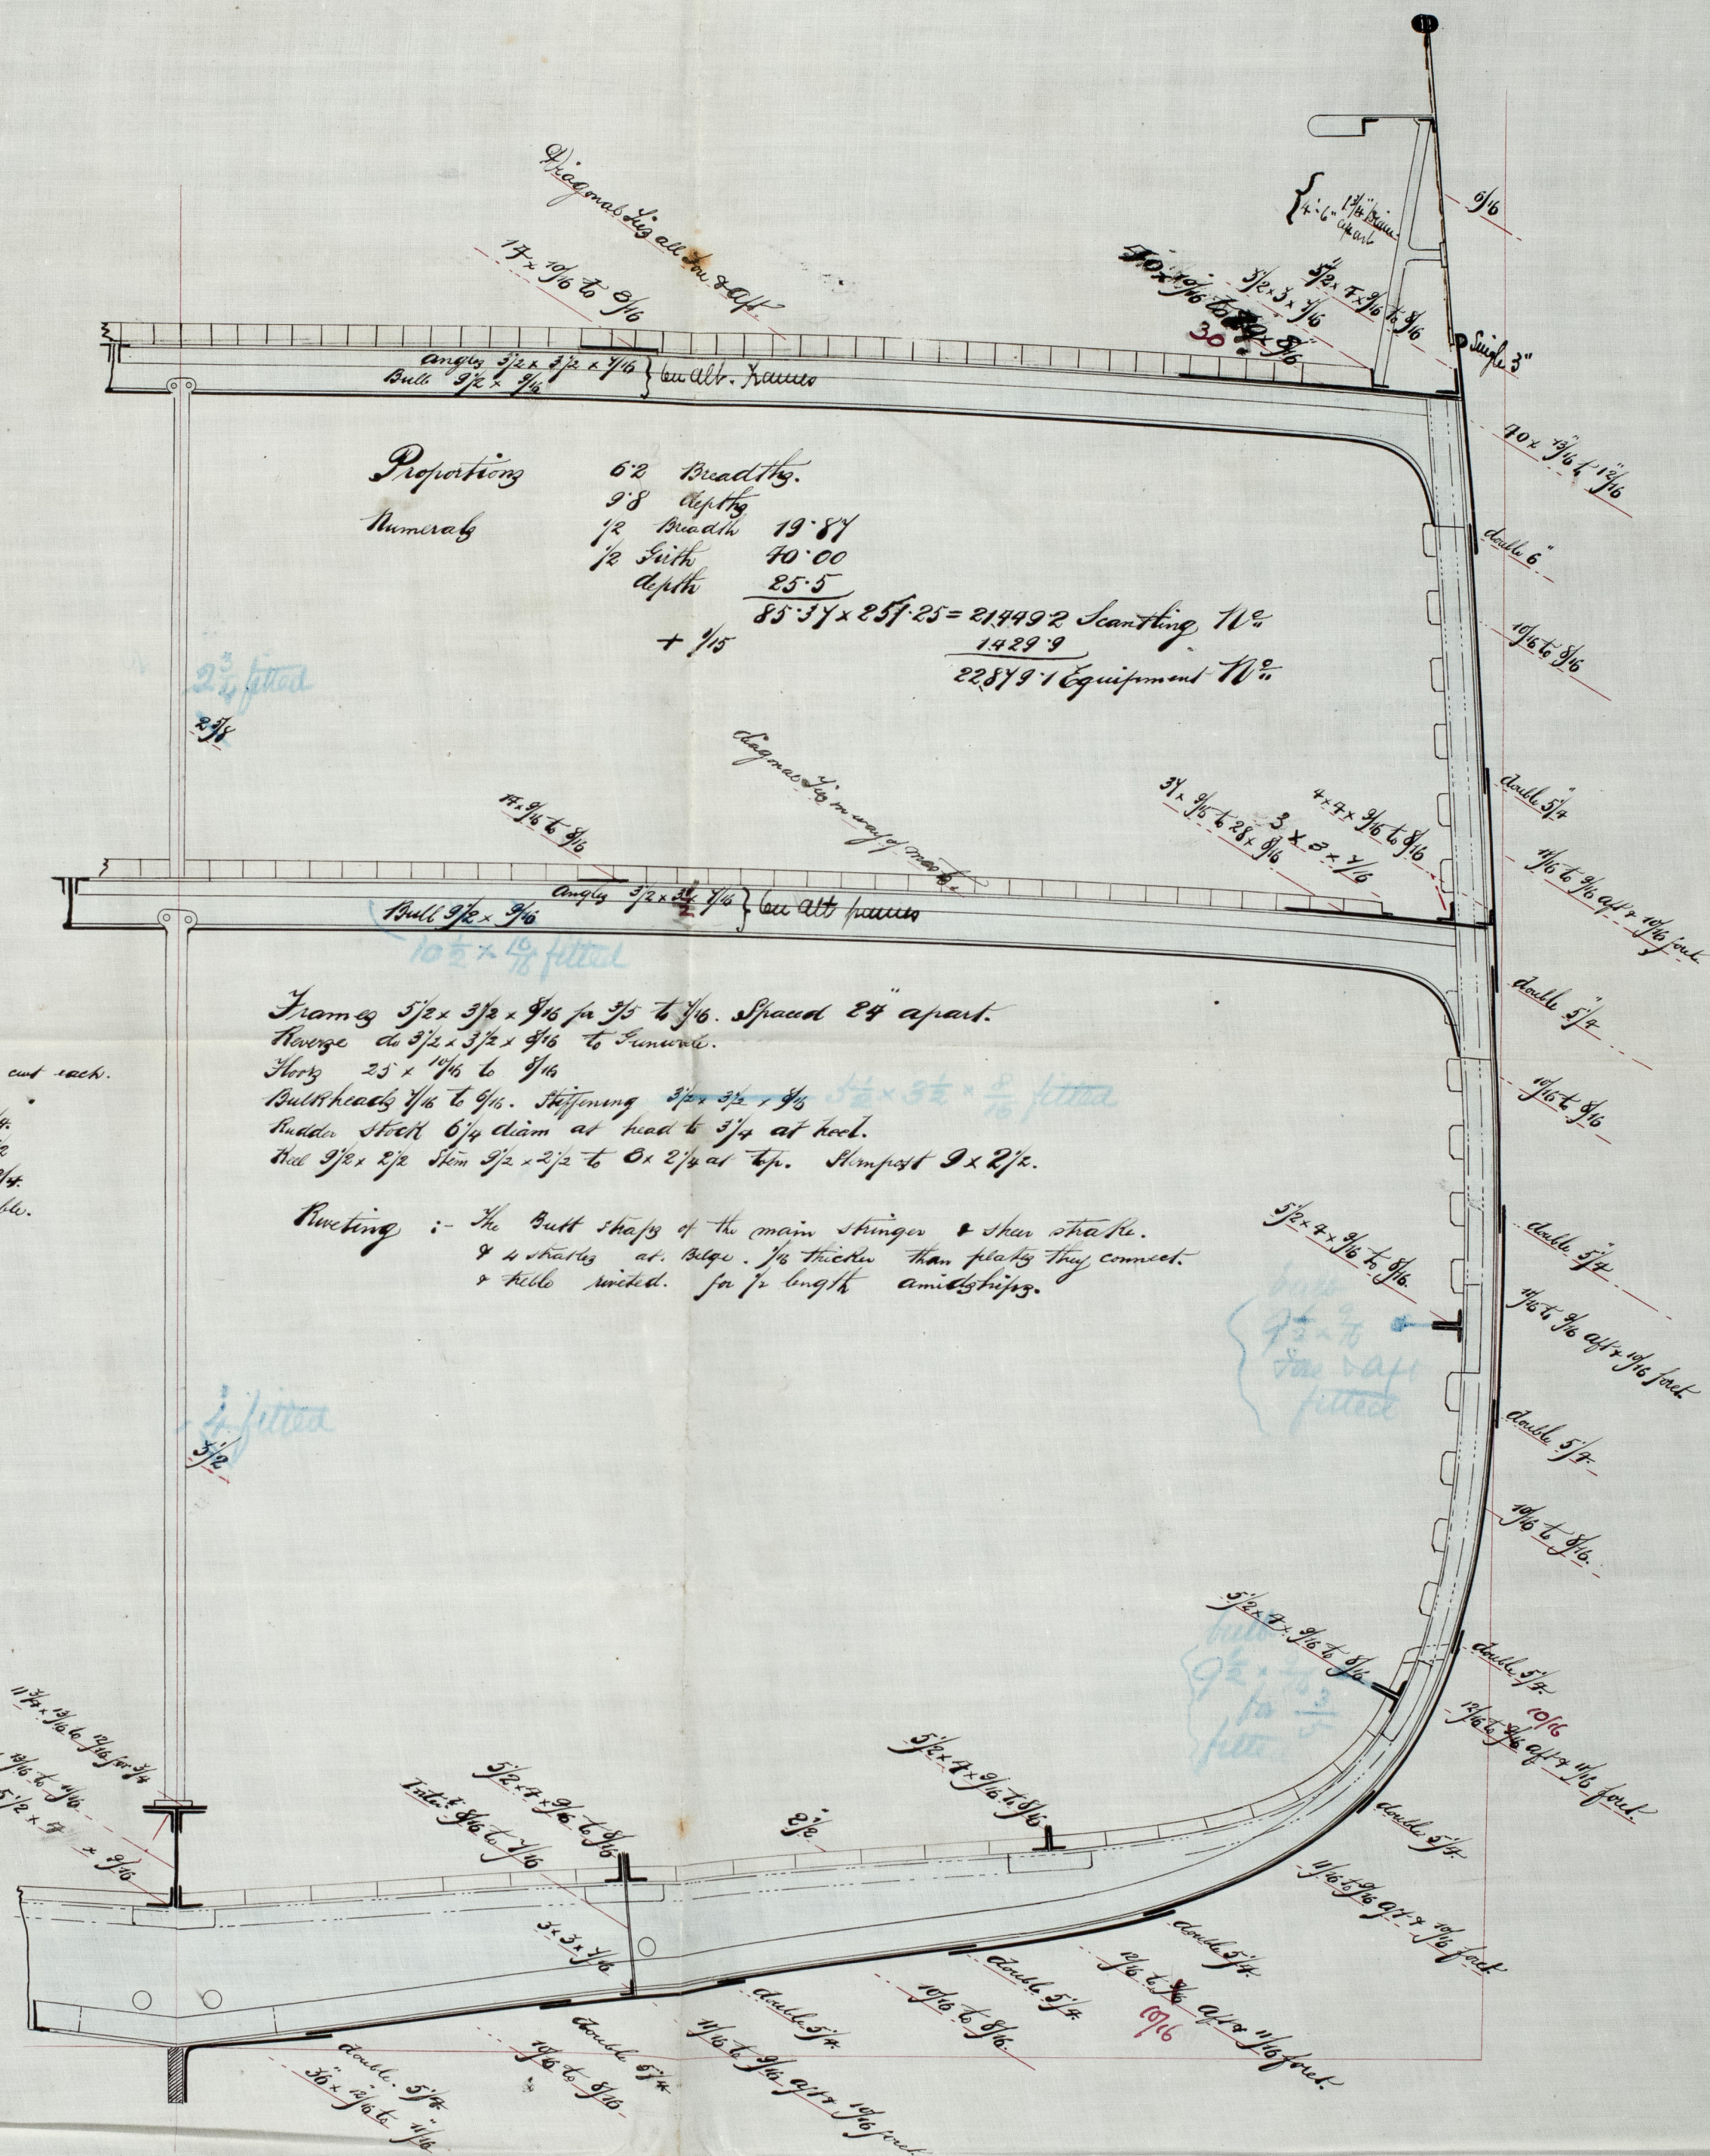

Equipment.

2	Brown anchors	4	Stock	36 1/2	cwt each.
1	"	"	"	31	"
1	Steam	"	"	4 1/4	"
1	Bridge	"	"	5 1/2	"
1	do	"	"	23 1/4	"
270	Lathings	1 3/4	Steel chain	calc.	
75	"	1 1/4	Steam chain		
20	"	11	Lathings		
10	"	10 1/2	Hand riv.		
90	"	6 1/2	Warp.		

From 5 1/2 x 3 1/2 x 9/16 in 3/5 to 1/16. Spaced 24" apart.

Reverse do $3\frac{1}{2} \times 3\frac{1}{2} \times \frac{9}{16}$ to $\frac{1}{16}$ in.

Floor 25 x 10 1/16 to 8 1/16

Bullheads $\frac{1}{16}$ to $\frac{9}{16}$. Steffenung $3\frac{1}{2} \times 3\frac{1}{2} \times \frac{9}{16}$ fether

Rudder stock $6\frac{1}{4}$ diam at head to $5\frac{1}{4}$ at keel.

Shel $9\frac{1}{2} \times 2\frac{1}{2}$ Stem $9\frac{1}{2} \times 2\frac{1}{2}$ to $8 \times 2\frac{1}{4}$ at top. Stem post $9 \times 2\frac{1}{2}$.

Shooting :- The Butt sharp of the main stringer & then strike.
 & 4 strikes at edge. No further than plates they connect.
 & little missed. for length amittstrips.

WORKMAN, CLARK & CO., LIMITED
SHIPBUILDERS &
MAY 12 83
ENGINEERS
BELFAST.

W. L.
1875/83

15.5.83

© 2021

Lloyd's Register
Foundation