


Dr to Bel 22/8/83.

For main & surging upper topsail yards No. 22 sailing ship. —
Scale $\frac{1}{4}$ inch = one foot. —

Fort George
Belfast Report No. 3033

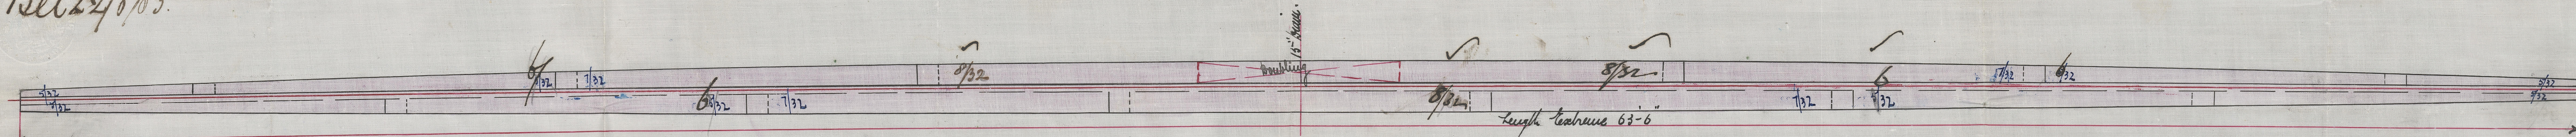

Dr letter to Surveyor

2/8/83



© 2021

Lloyd's Register
Foundation

Bel 9
30 33








