

Lloyd's Register of British and Foreign Shipping.

(Received in the London Office,



P.

No. 496

REPORT ON SHIP FORGINGS.

Sir,

I beg leave to report that the undermentioned Forgings, manufactured by The Portland Forge Co of Hilmarock for the Vessel No. 21, being built by Messrs McIlwaine, Lewis & Co of Belfast have been inspected by me in course of being forged and smithed, and found to be, so far as can be seen, sound and satisfactory

ms 5/10/83

Mark on Forging.

Lloyd's

No. 496

G.N

The Secretary,
London.

I am, Sir,


Your Obedient Servant,

George Newcomb

Glasgow

	STERN FRAMES.	RUDDER FRAMES.	STEMS.
Material* - - - -	<i>Scrap iron</i>	/	/
How made - - - -	<i>Forged</i>		
Dimensions - - - -	<i>7 x 3</i>		
Progress on Inspection -	<i>Forged and smithed</i>		
Dates when Inspected -	<i>3.14.24.27.29/9/83.</i>		

SKETCHES OF FRAMES SHEWING POSITION AND DESCRIPTION OF WELDS.

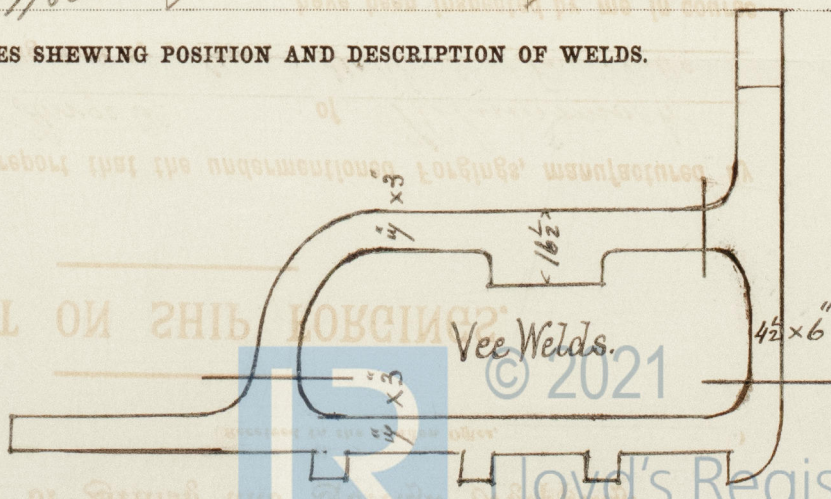

* If of iron, state whether scrap or puddled iron.

S.S. Thorne
Belfast Report
No 3040

REPORT ON SHIP FORGINGS



© 2021

Lloyd's Register
Foundation

LR/PUN/Bel52A/62R