
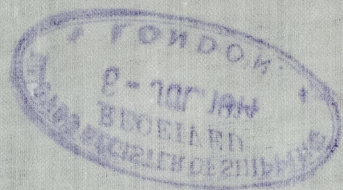


Tracing No 1058.

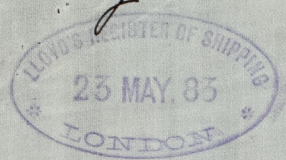

Dr. L. R. L.
23/5/83.

"S. S. Thorne" NEW
Belfast Report No 3040

S. S. No 21

15'9"-2" x 23'-0" x 11'-4" (top of floors)


To Class 100 A. I. at Lloyds

Scale 1/2" = one foot

6.87 Breadths


12.56 Depths

Half Girth = 21.45
Half Breadth 11.5
Depth 12.58
 $\frac{45.53}{15.8} = 1^{st} No$
 $\frac{36424}{22765} = 2^{nd} No$
 $\frac{4553}{7193.74} = 2^{nd} No$
 $\frac{480}{7673} = Equip^{t} No$

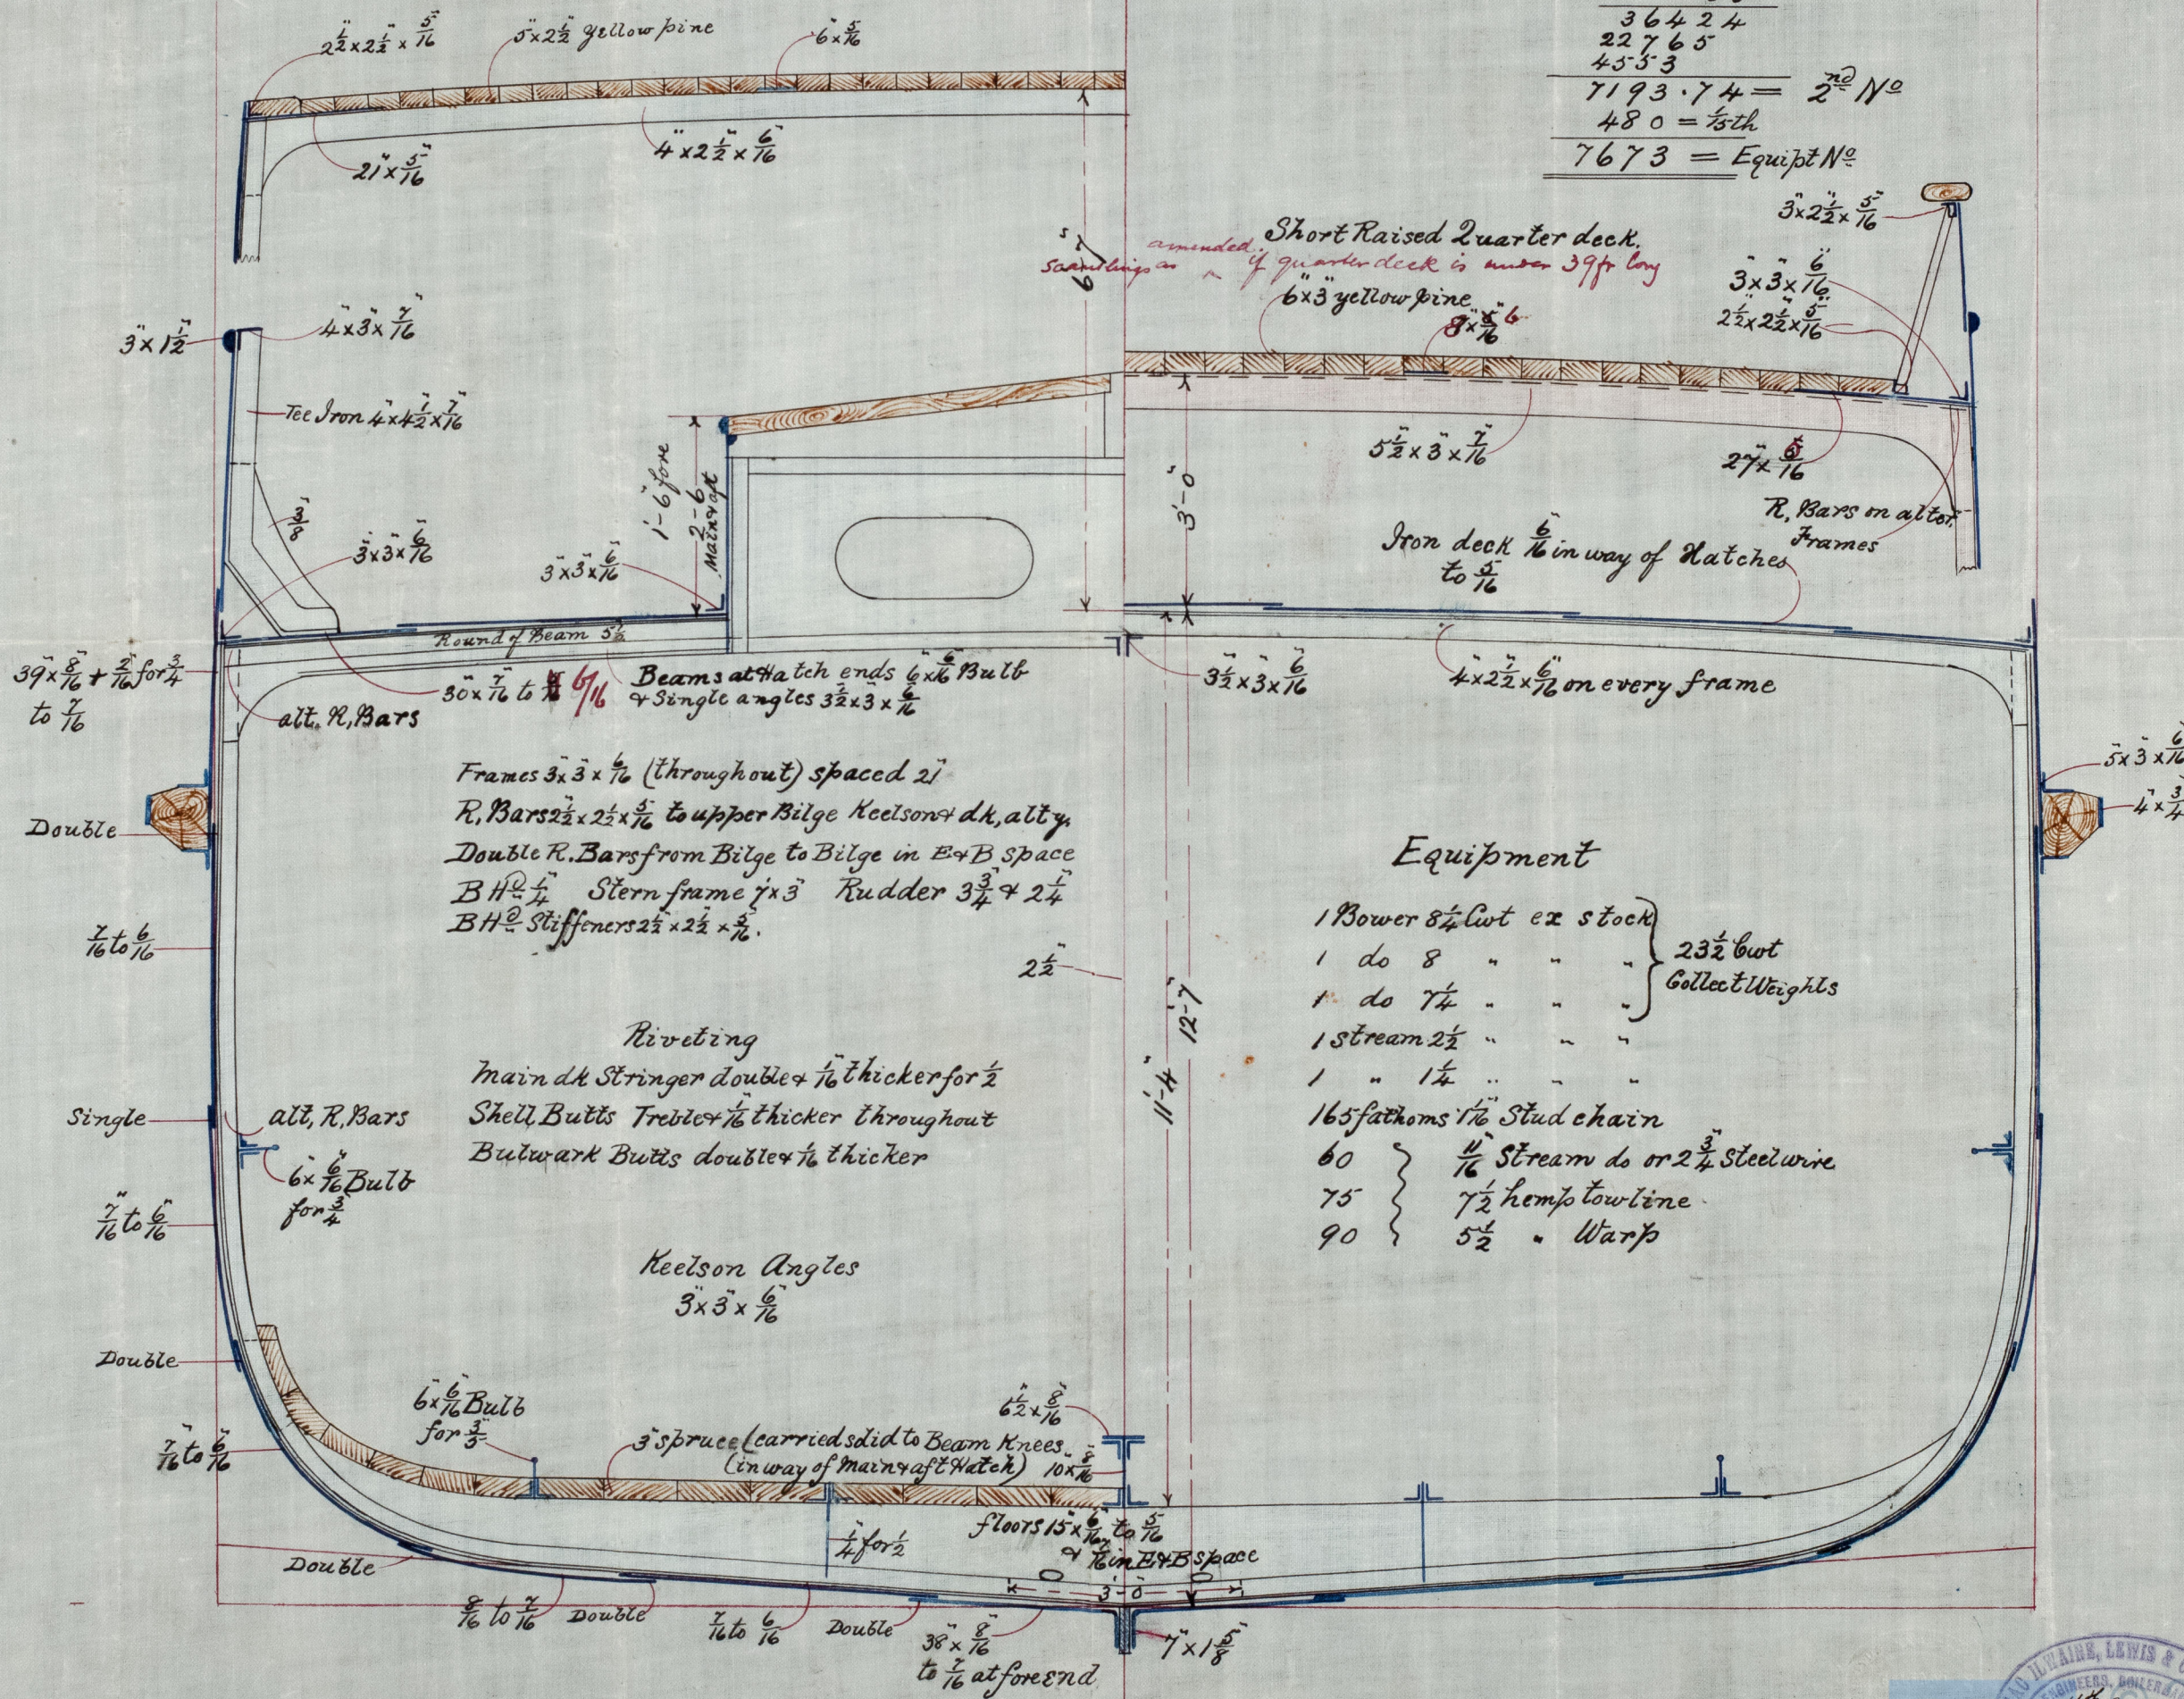

Equipment

1 Bower 8 1/4 cwt ex stock
1 do 8 " " " 23 1/2 cwt
1 do 7 1/4 " " " Collect Weights
1 stream 2 1/2 " " "
1 " 1 1/4 " " "
165 fathoms 1/16 Stud chain
60 } 1/16 Stream do or 2 3/4 Steel wire
75 } 7 1/2 hemp towline
90 } 5 1/2 " Warp

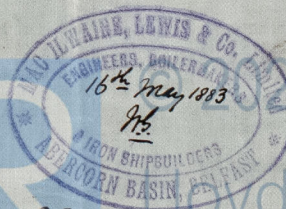

23/5/83

21.5.83

Lloyd's Register Foundation