


Pumping Arrangement for Nos 18 & 20 S.S. ~ "Jane Clark" (N^o 18)
Scale $\frac{1}{8}$ inch = one foot. ~ Belfast Report N^o 3000

0 S.S. ~ "Jane Clark" (N^o 18)
Belfast Report N^o 3000
N^o 20 "Maria A. Hyde"
Belfast Report N^o 3012
N^o 24 "Corra Linn"
Belfast Report N^o

15-5-83

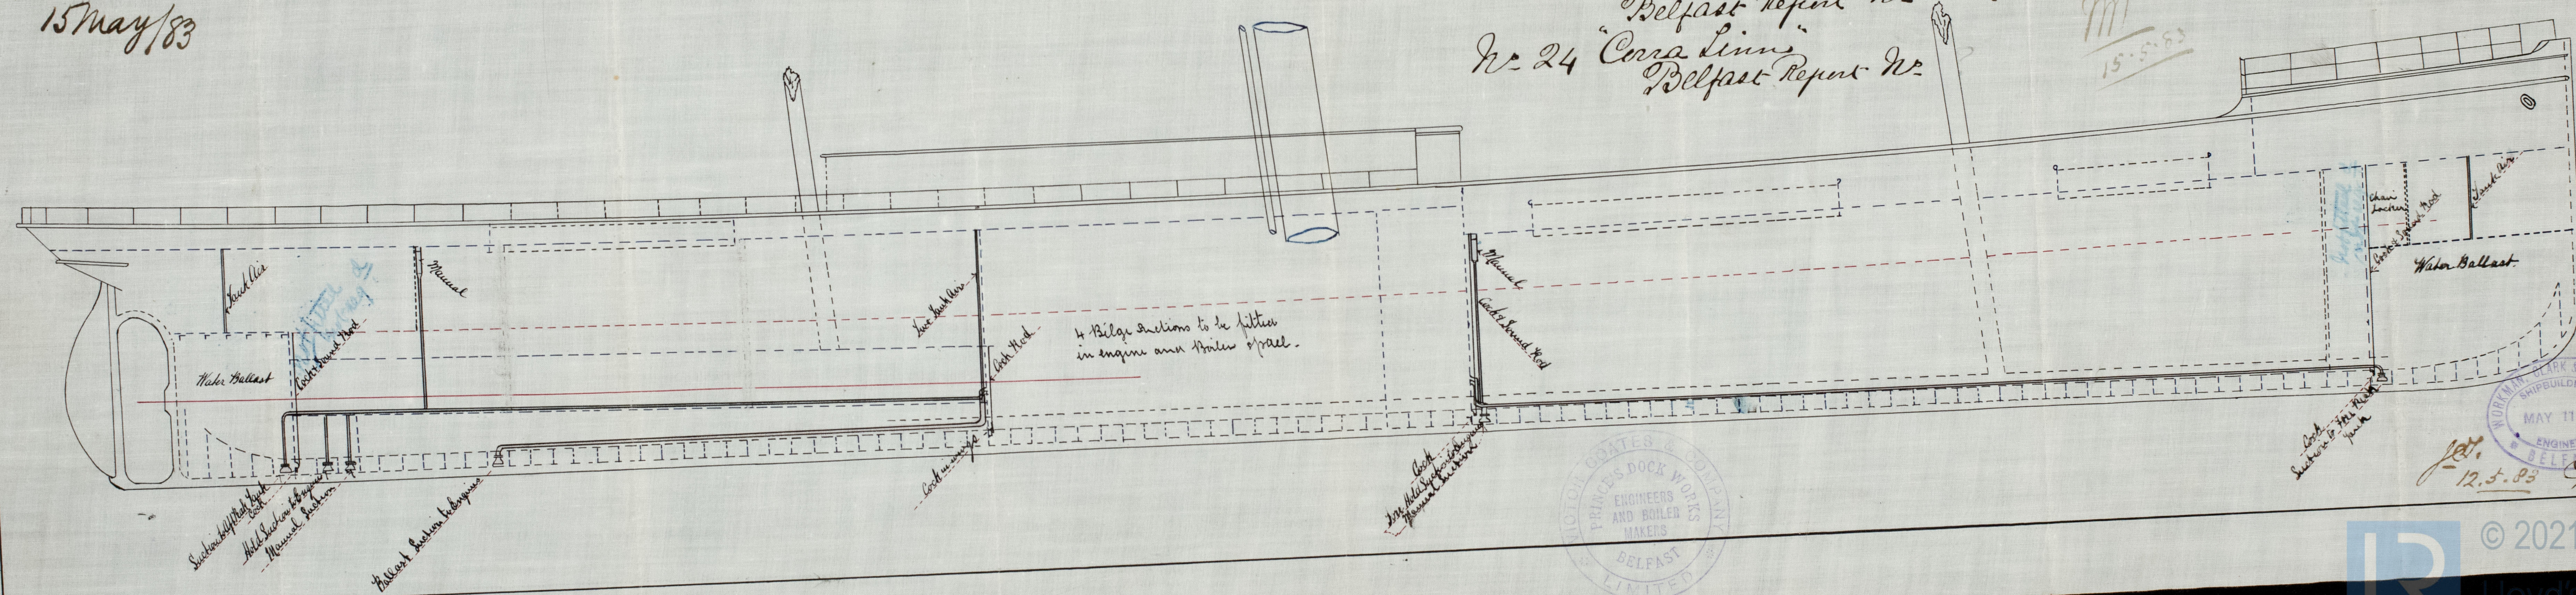

Book
number is 700
your

WORKMAN, CLARK & CO., LIMITED
SHIPBUILDERS &
MAY 11 83
ENGINEERS
BELLEVILLE

12.5.83

14888

