


Ltr: to Belfast
27/11/82

Section at Fore end Water Ballast Tank 8th 18 S.S. *Line Clark*
To Class 100 & 1. Belfast Report
No 3000
Scale $\frac{1}{2}$ " inch = one foot. "*Corra Linn*"
Belfast Report
No 3047

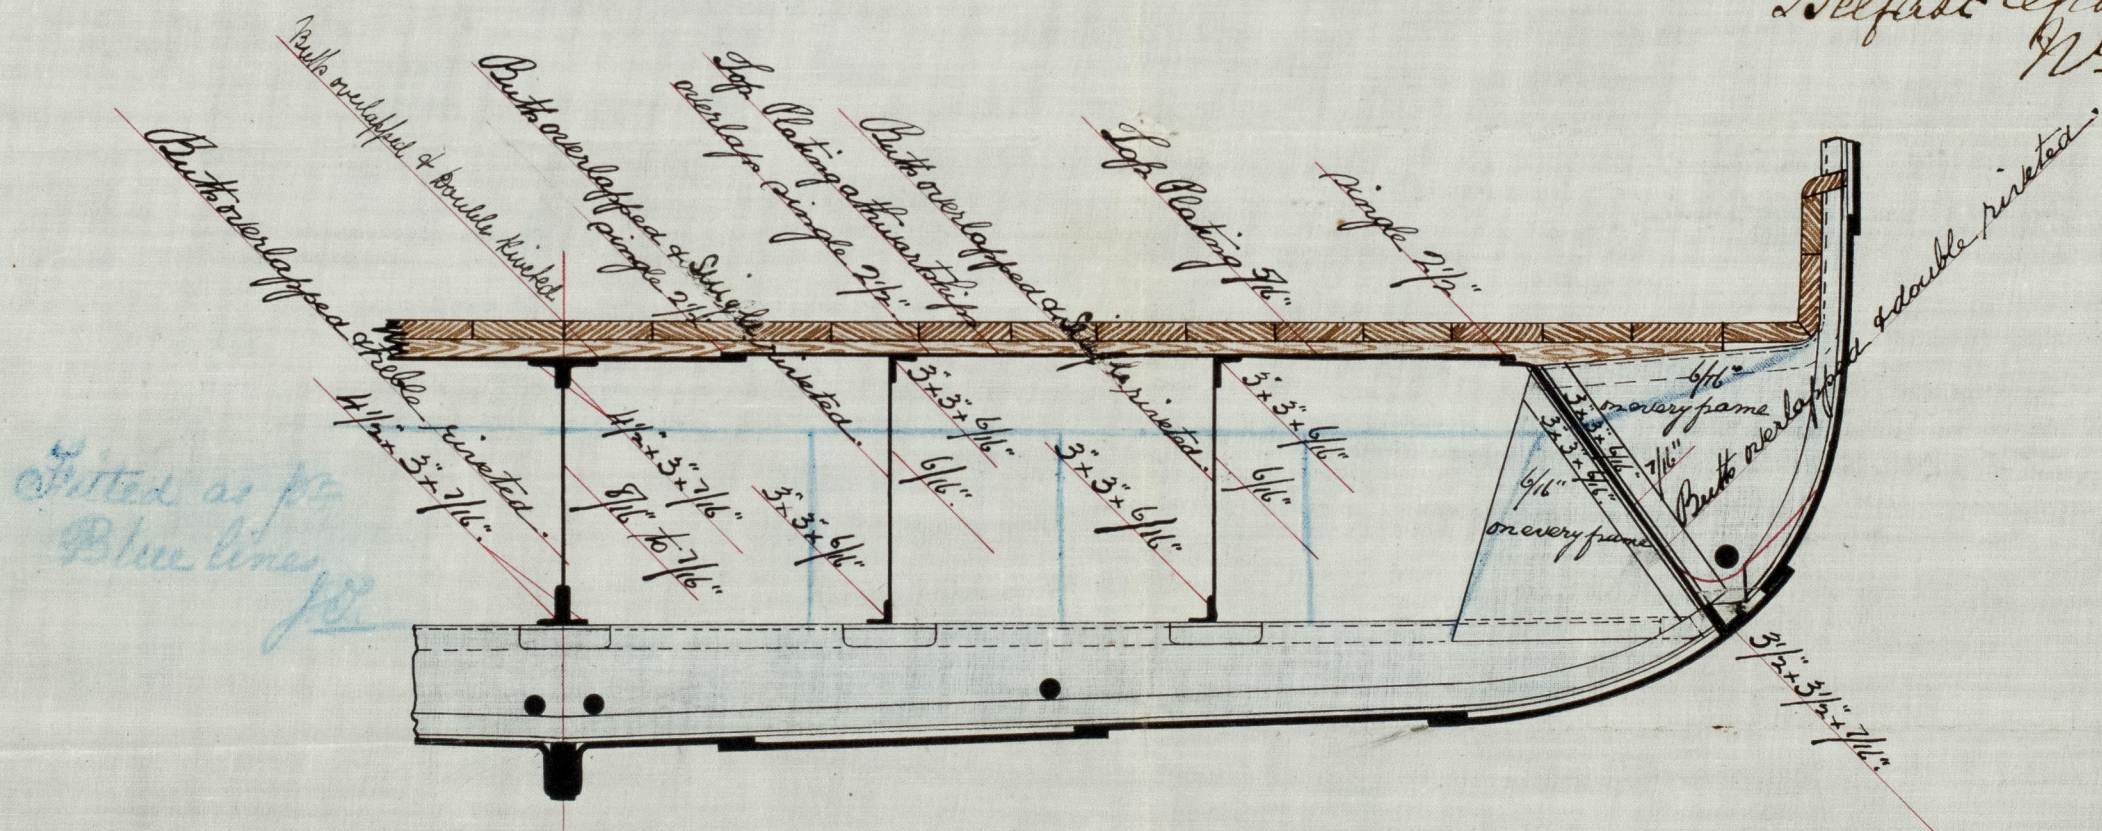

Noted as per
Blue lines
J.C.

J.C. 4.11.82

J.H.
6/11/82

