


RECEIVED 20 APR 83
RECEIVED 20 APR 83
RECEIVED 20 APR 83

Dr. to Bel.
9/4/83.
5/4/83.

S.S. "Horn Head"
Belfast Report N^o 3053

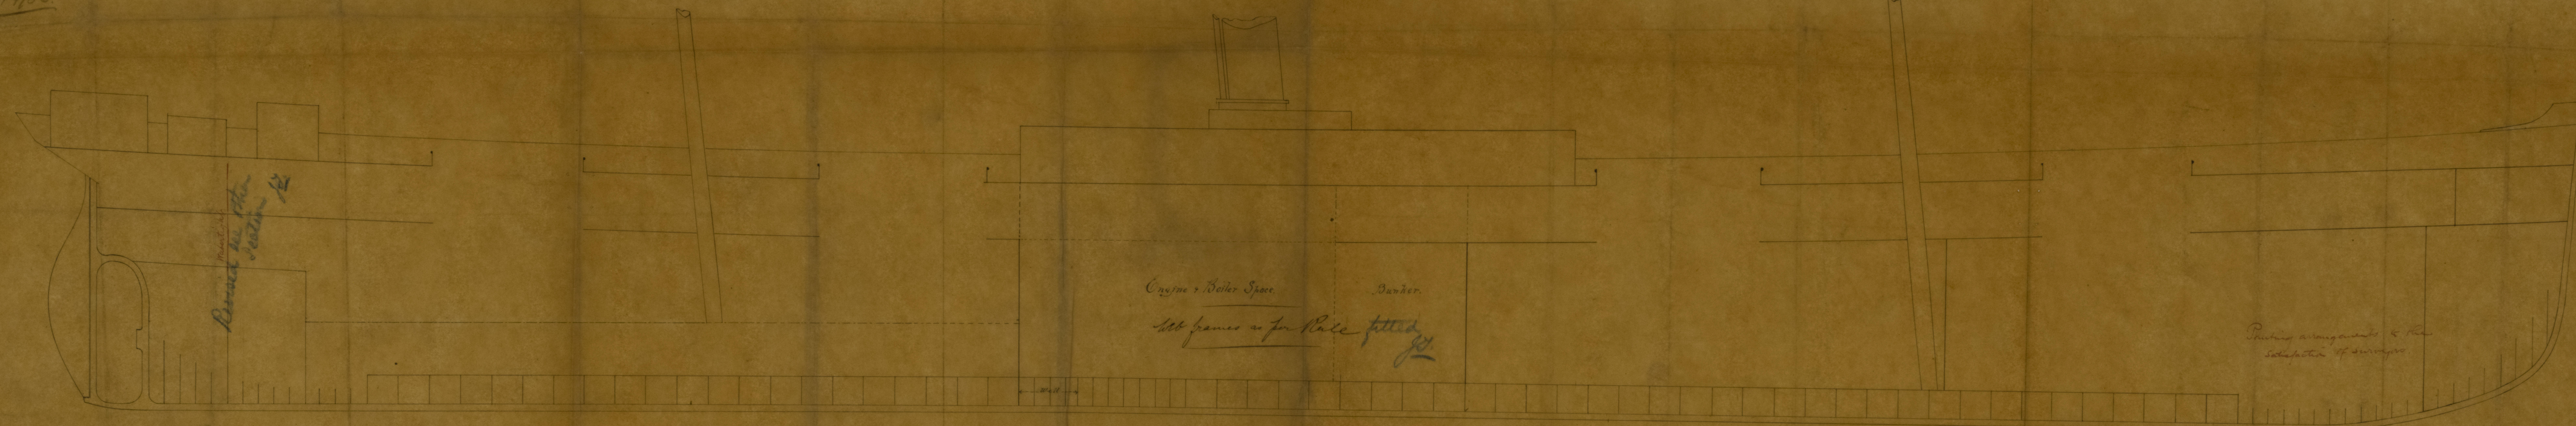

Drawn by the
Surveyor 12


Engine & Boiler Space

Banker

100 frames as per Rule fitted

Pushing arrangements & the
satisfaction of surveyors

N^o 165
IRON S.S. "HORN HEAD"
320' x 37' x 28' 8 1/2" (Top of keel)
SPAR DECK RULE
SCALE 1/8" = ONE FOOT.

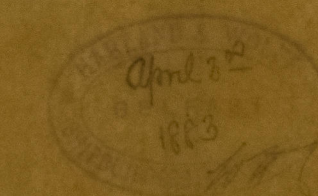

© 2021
Lloyd's Register
Foundation