

Lloyd's Register of British and Foreign Shipping.

(Received in the London Office,



P.

No. 443

REPORT ON SHIP FORGINGS.

Sir,

I beg leave to report that the undermentioned Forgings, manufactured by The Govan Forge Co of Glasgow for the Vessel No. 166, being built by Messrs Harland & Wolff of Belfast have been inspected by me in course of being forged and smithed, and found to be, so far as can be seen, sound and efficient

Jm 27/9/83

Mark on Forging.

Lloyd's

No. 443

G. N

I am, Sir,

Your Obedient Servant,


George Newcomb

The Secretary,
London.

Glasgow

| | STERN FRAMES. | RUDDER FRAMES. | STEMS. |
|--------------------------|---|----------------|--------|
| Material* - - - - | <i>Scrap iron</i> | / | / |
| How made - - - - | <i>Forged</i> | | |
| Dimensions - - - - | <i>11 x 6 1/2</i> | | |
| Progress on Inspection - | <i>Forged & smithed</i> | | |
| Dates when Inspected - | <i>9.11.26.31/7/83. 4.7.10.13.22.29/8/83. 17.19.20.26/9/83.</i> | | |

SKETCHES OF FRAMES SHEWING POSITION AND DESCRIPTION OF WELDS.

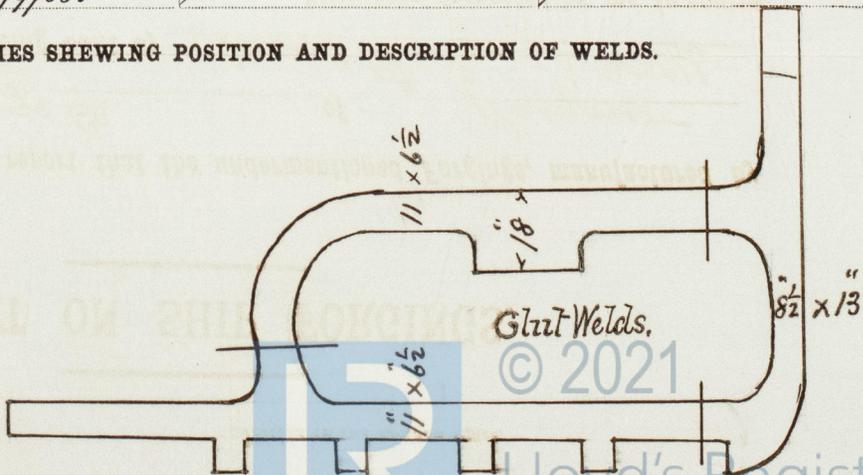

S. L. Lord O'Neill
Belfast Report
N^o 3068

REPORT ON SHIP FORGINGS.



© 2021

Lloyd's Register
Foundation

Dec 1.10.83

LR/PUN/Be152A/150R