

Lloyd's Register of British and Foreign Shipping.

(Received in the London Office,

F.

No. 443

REPORT ON SHIP FORGINGS.

Sir,

I beg leave to report that the undermentioned Forgings, manufactured by The Govan Forge Co of Glasgow for the Vessel No. 166, being built by Messrs Harland & Wolff of Belfast have been inspected by me in course of being forged and smithed, and found to be, so far as can be seen, sound and satisfactory

Mark on Forging.

Lloyd's

No. 443

G. N.

The Secretary,
London.

I am, Sir,


Your Obedient Servant,

George Newcomb

Glasgow

	STERN FRAME.	RUDDER FRAME.	STEM.
Material* - - - -	/	Scrap iron	/
How made - - - -		Forged	
Dimensions - - - -		8 1/2 dia	
Progress on Inspection -		Forged and smithed	
Dates when Inspected {		14.25/9/83. 3.18.24.30/10/83. 8.16.20/11/83. 25/12/83.	

SKETCHES OF FRAMES SHEWING POSITION AND DESCRIPTION OF WELDS.

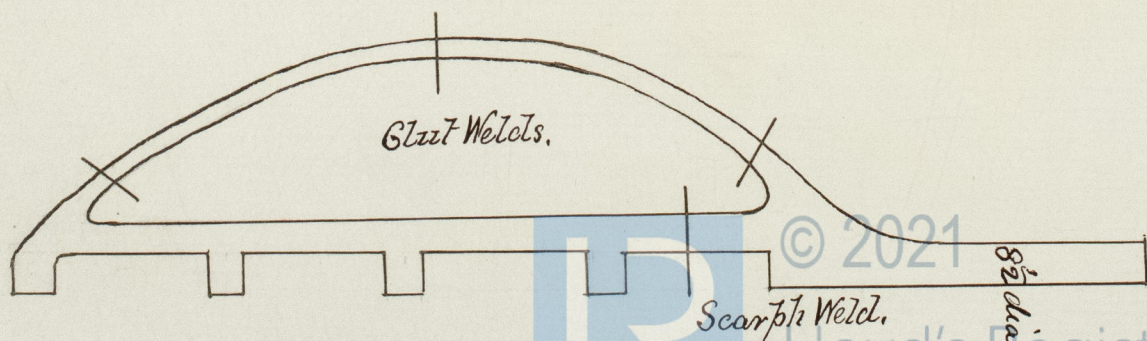

London.
The Secretary.









