

Lloyd's Register of British and Foreign Shipping.

(Report on Vessel No. 25 Port Belfast)

No. 575 SHIP FORGINGS OR CASTINGS.

I have to report that the undermentioned Iron or Steel Forgings or Castings, manufactured by Messrs. the Darlington Forge Co of Darlington for the Vessel No. 25, being built by Messrs. Mathman Clark & Co. of Belfast have been inspected by me as set forth below, and found to be, so far as can be seen, sound.


Mark on Forgings.

Lloyd's
No. 575
R.C.

H. Cannon.
Sunderland.

	STERN FRAME.	RUDDER FRAME.	STEM.
Material*	<u>Scrap Iron</u>	<u>Scrap Iron</u>	<u>Scrap Iron</u>
How made	<u>Forged</u>	<u>Forged</u>	<u>Forged</u>
Dimensions	<u>10" x 4"</u>	<u>10 1/2" x 4 3/4"</u>	<u>11" x 3"</u>
Progress on Inspection	<u>Forged Smithed</u>	<u>Forged Smithed</u>	<u>Forged</u>
Dates when Inspected	<u>Nov 7-6-12-14-21</u> <u>Dec 1-6-11-19</u> <u>22</u> <u>Jan 4-16-26/84</u>	<u>Nov 11-14-24</u> <u>April 8-22</u> <u>May 9-14-21-24-28/84</u>	<u>Oct 22</u> <u>Nov 6-12/83</u>

SKETCHES OF FRAMES SHEWING POSITION AND DESCRIPTION OF WELDS OF FORGINGS, OR PARTICULARS OF TESTS APPLIED TO CASTINGS.

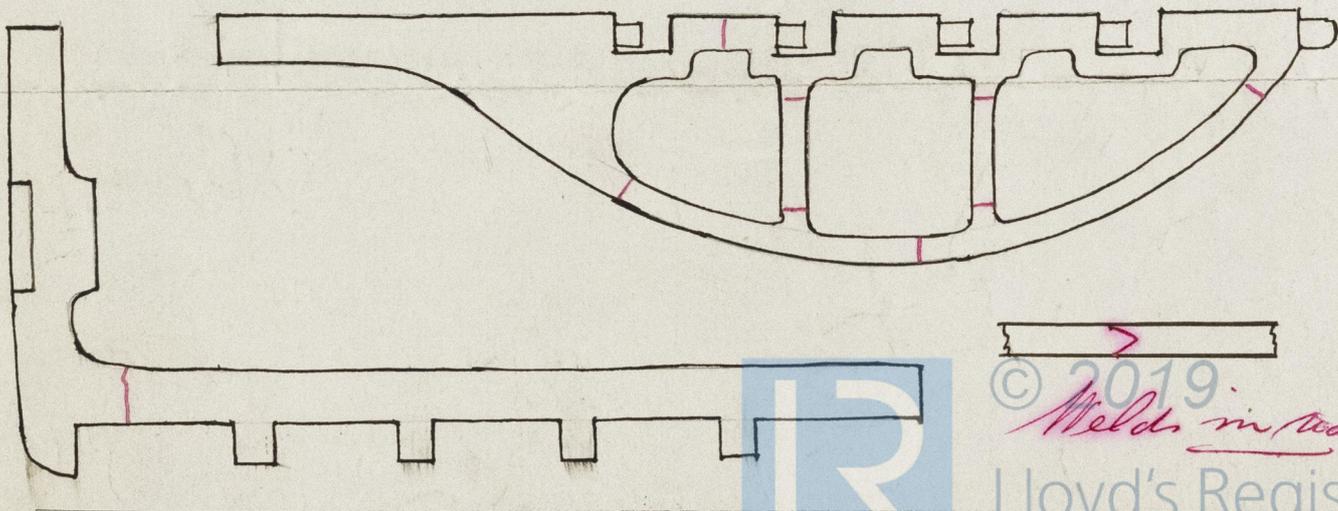

© 2019
Welds in red

Lloyd's Register
Foundation

* If of Iron, state whether scrap or puddled iron.

"S. S. River Indus"
Belfast Report
N^o 3105



© 2019

Lloyd's Register
Foundation