


Mar 11/83

— Pumping Arrangement No 25 J. S. S. "Parr. Indus" —

Scale  $\frac{1}{8}'' = \text{one Foot}$

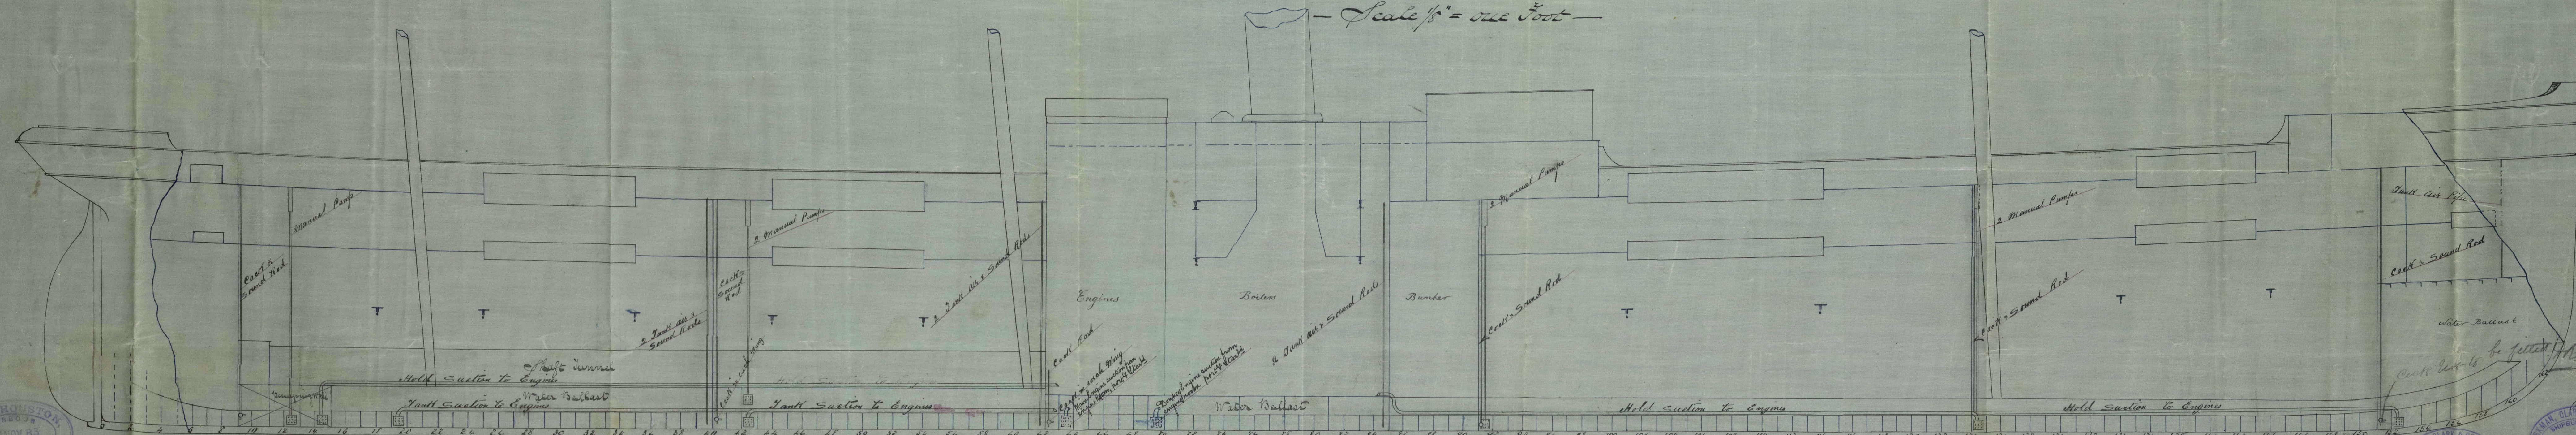

Barin. 20/11/83

Lloyd's Register  
BE453-0027