

LLOYD'S REGISTER OF SHIPPING
RECEIVED
21 NOV. 83
LONDON

LONDON
L. B. B.

27/9/83.

27:11:83.


LOVE'S REGISTER OF SHIPMENTS
RECEIVED
26 NOV 85
LONDON

Half Midship Section No. 25. F. S. S. [330' x 43' x 28']

Class 100 A 1 at Lloyd's 3 Deck rule [Scale $\frac{1}{2}'' = 1 \text{ foot}$]

[Working numbers 93 & 31,000 as per Spec.]

River Indus Twin S.S.
Belfast Report
No. 3105

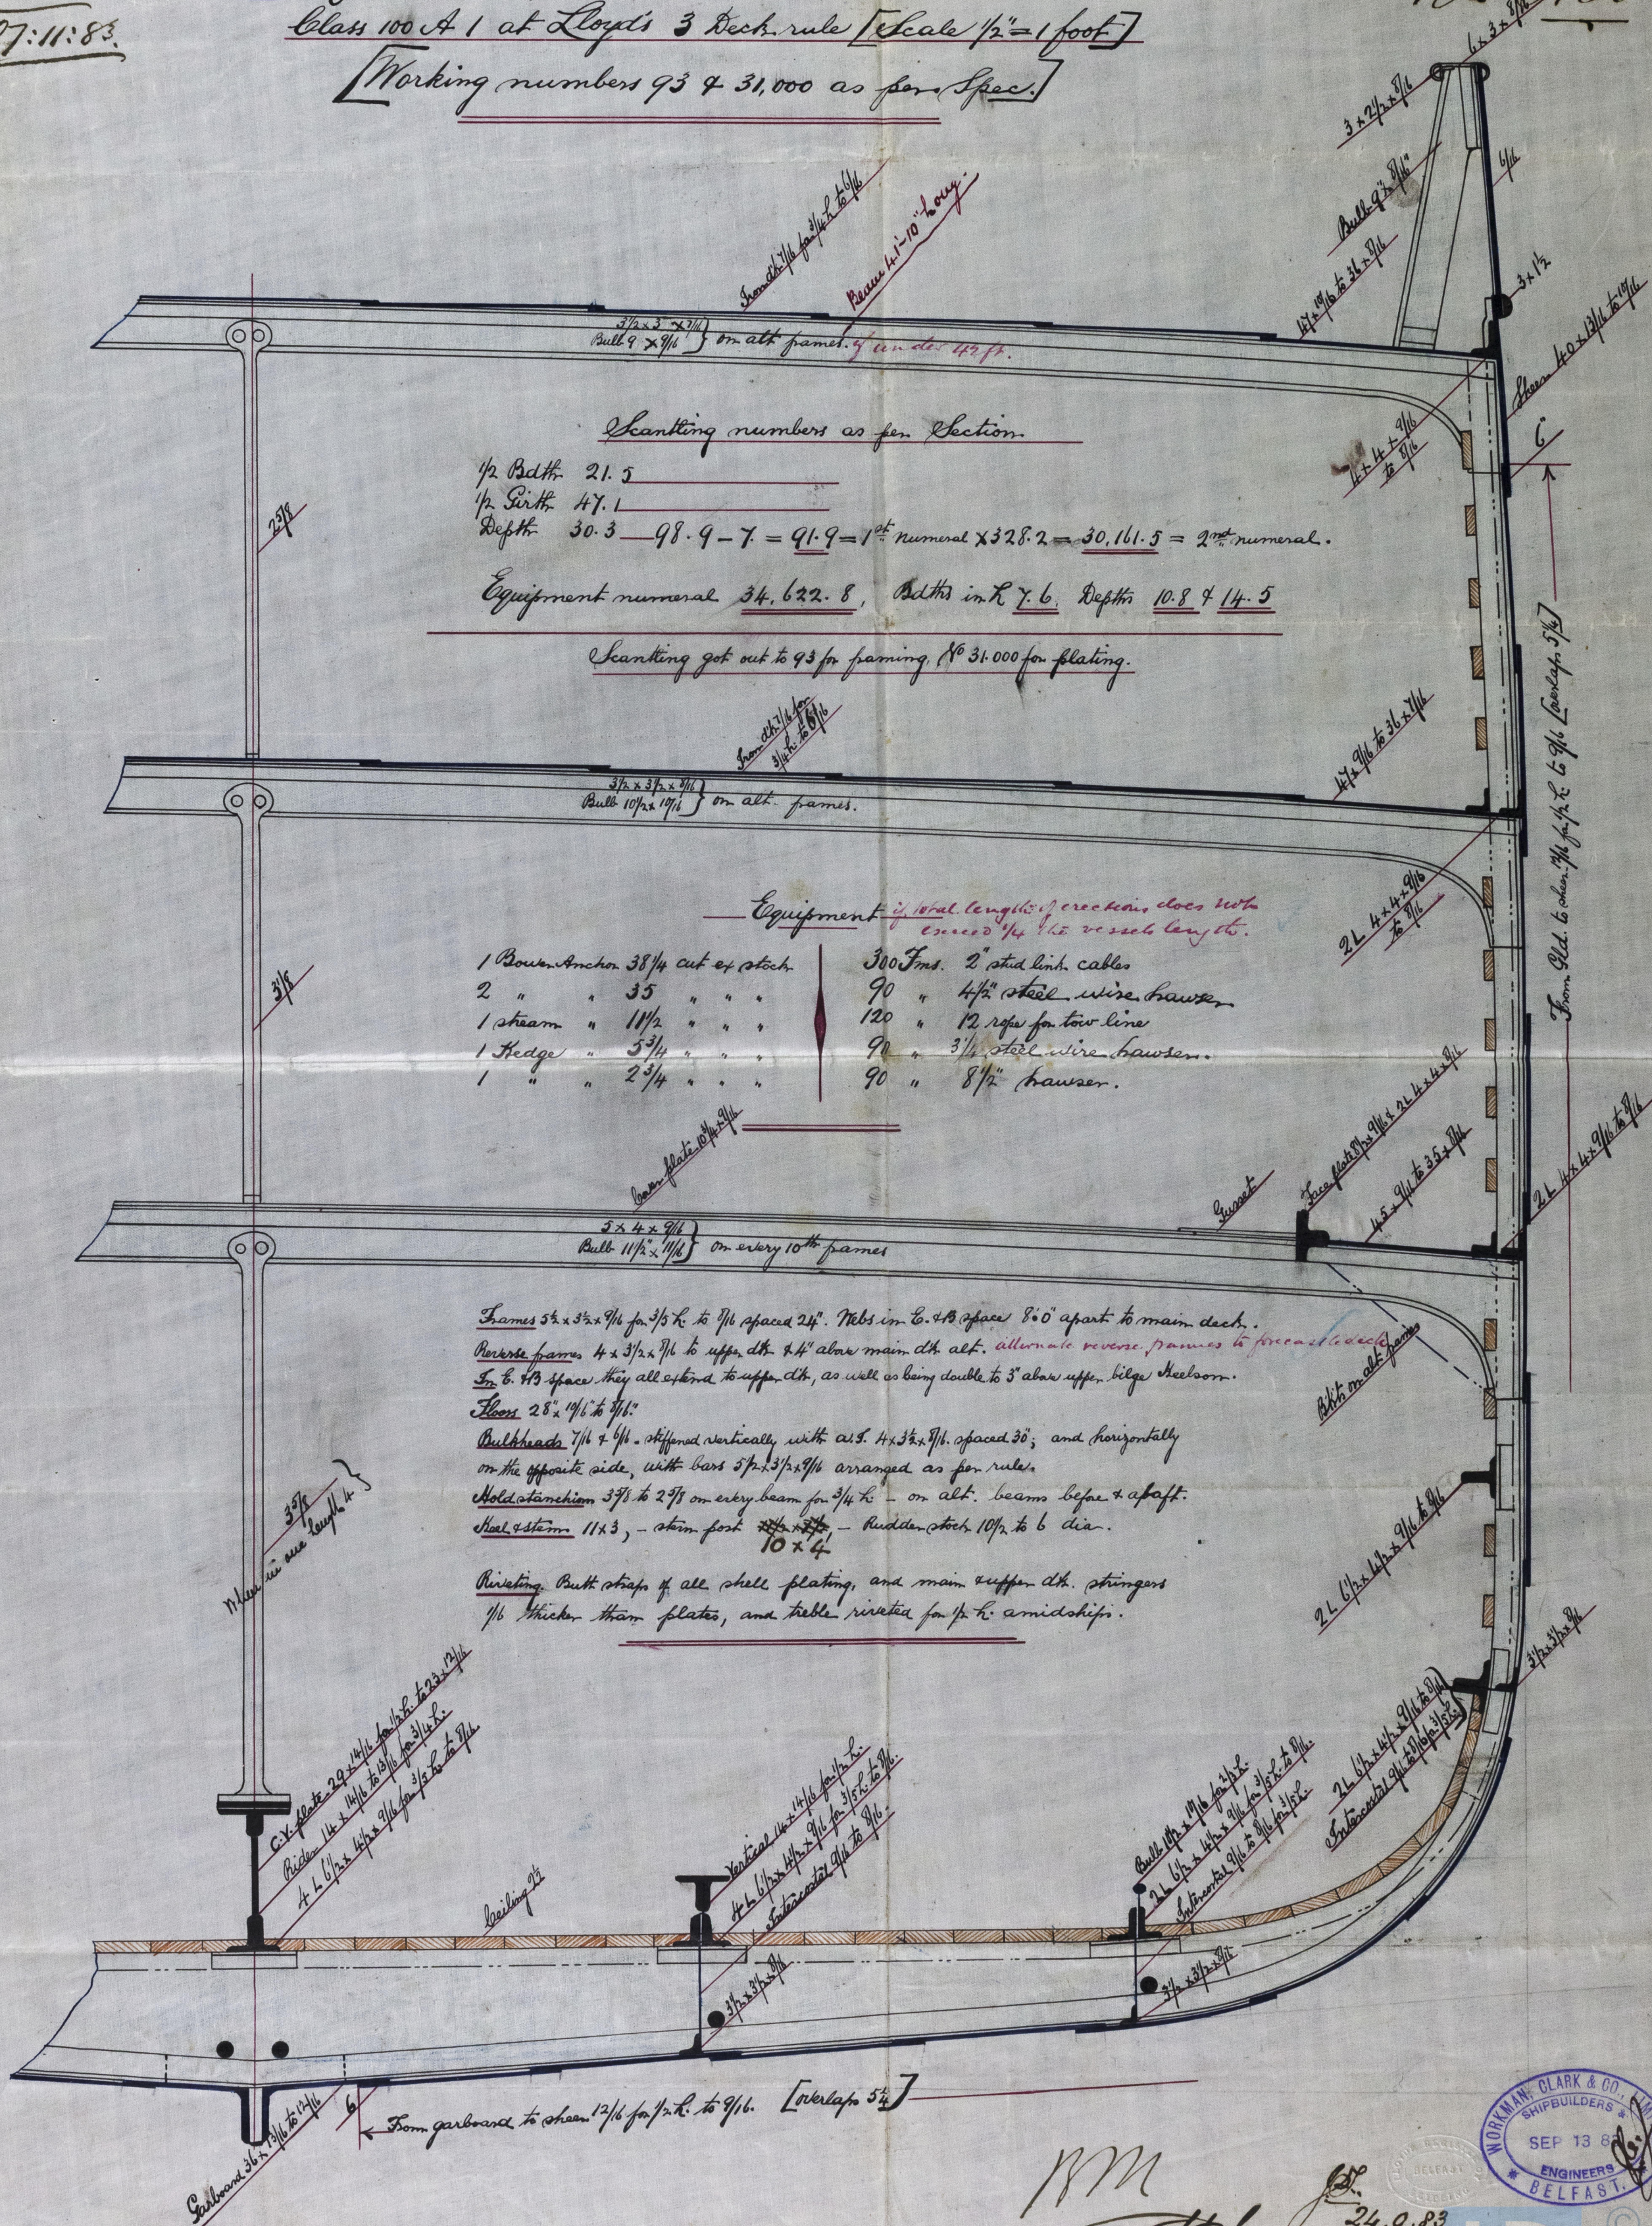

BM

St. J.
25/9/83

24.9.83

© 2019

BE 53-0028