
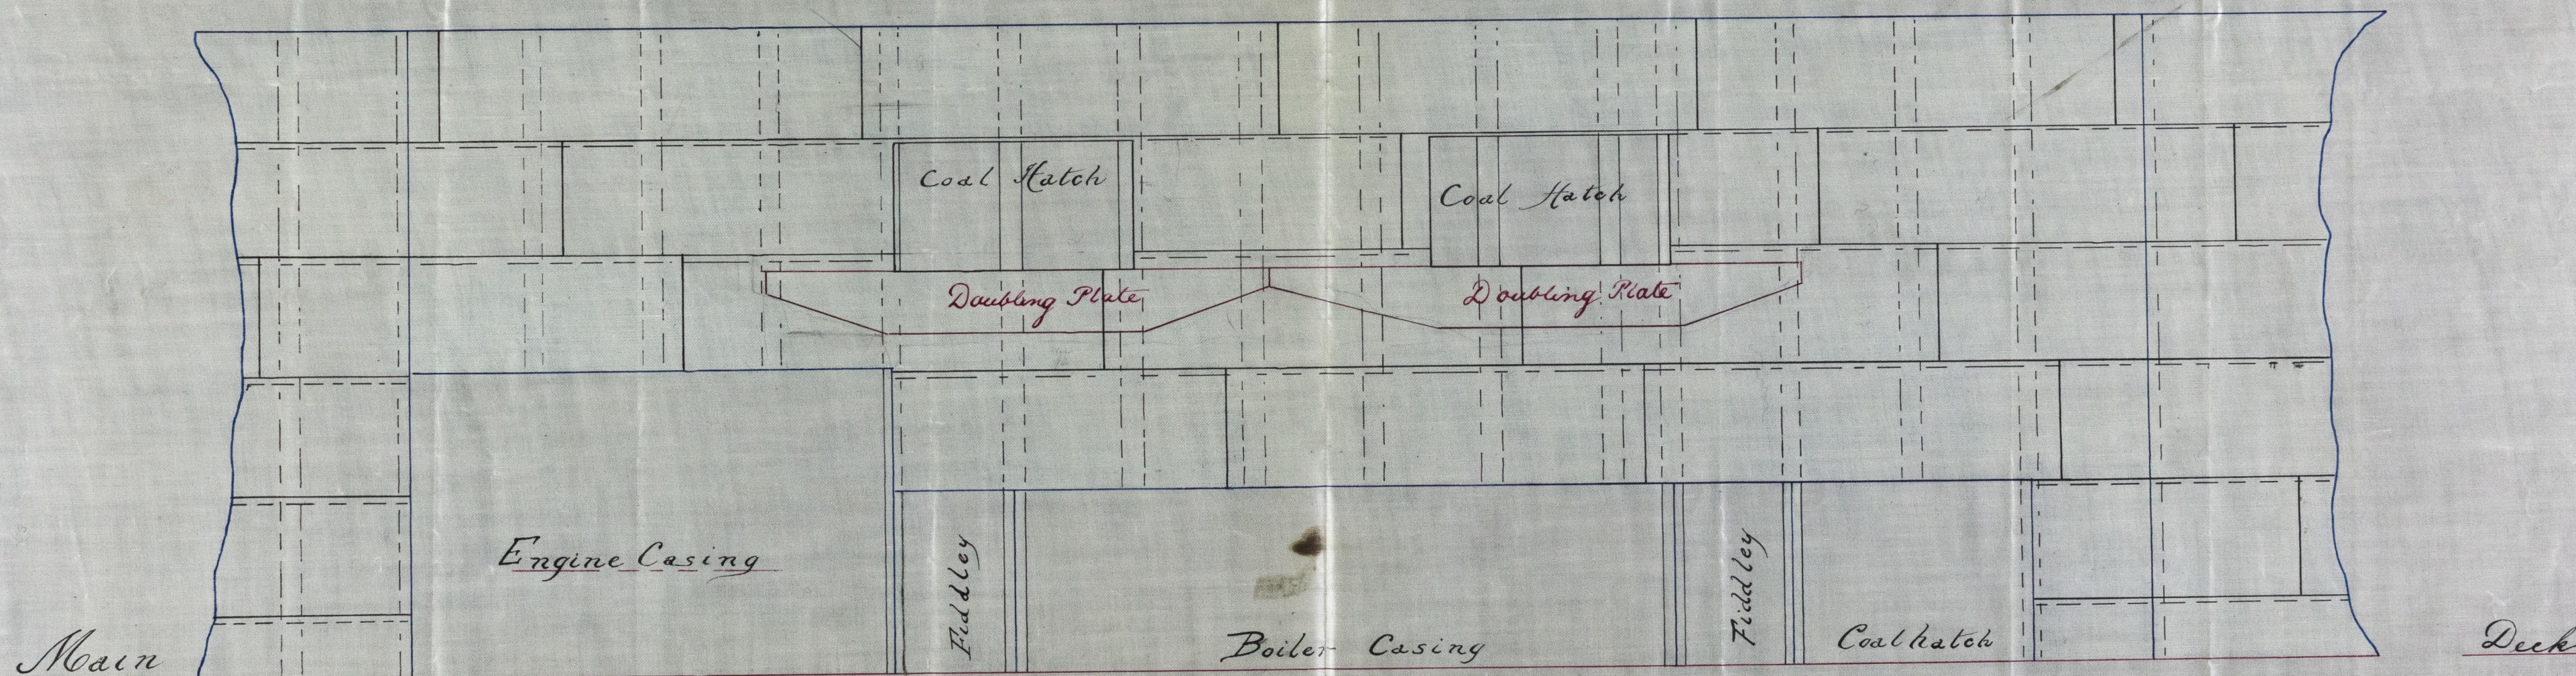


Lt. J. Bell:
27.11.83

LLOYD'S REGISTER OF SHIPBUILDERS
RECEIVED
26 NOV. 83
LONDON

Sketch of Upper & Main deck plans No 25 T. S. S. *River Indus*
Showing Arrangement of Engine & Boiler Casings & Belfast Report
No. 3105

Scale $\frac{1}{4}$ " = one foot

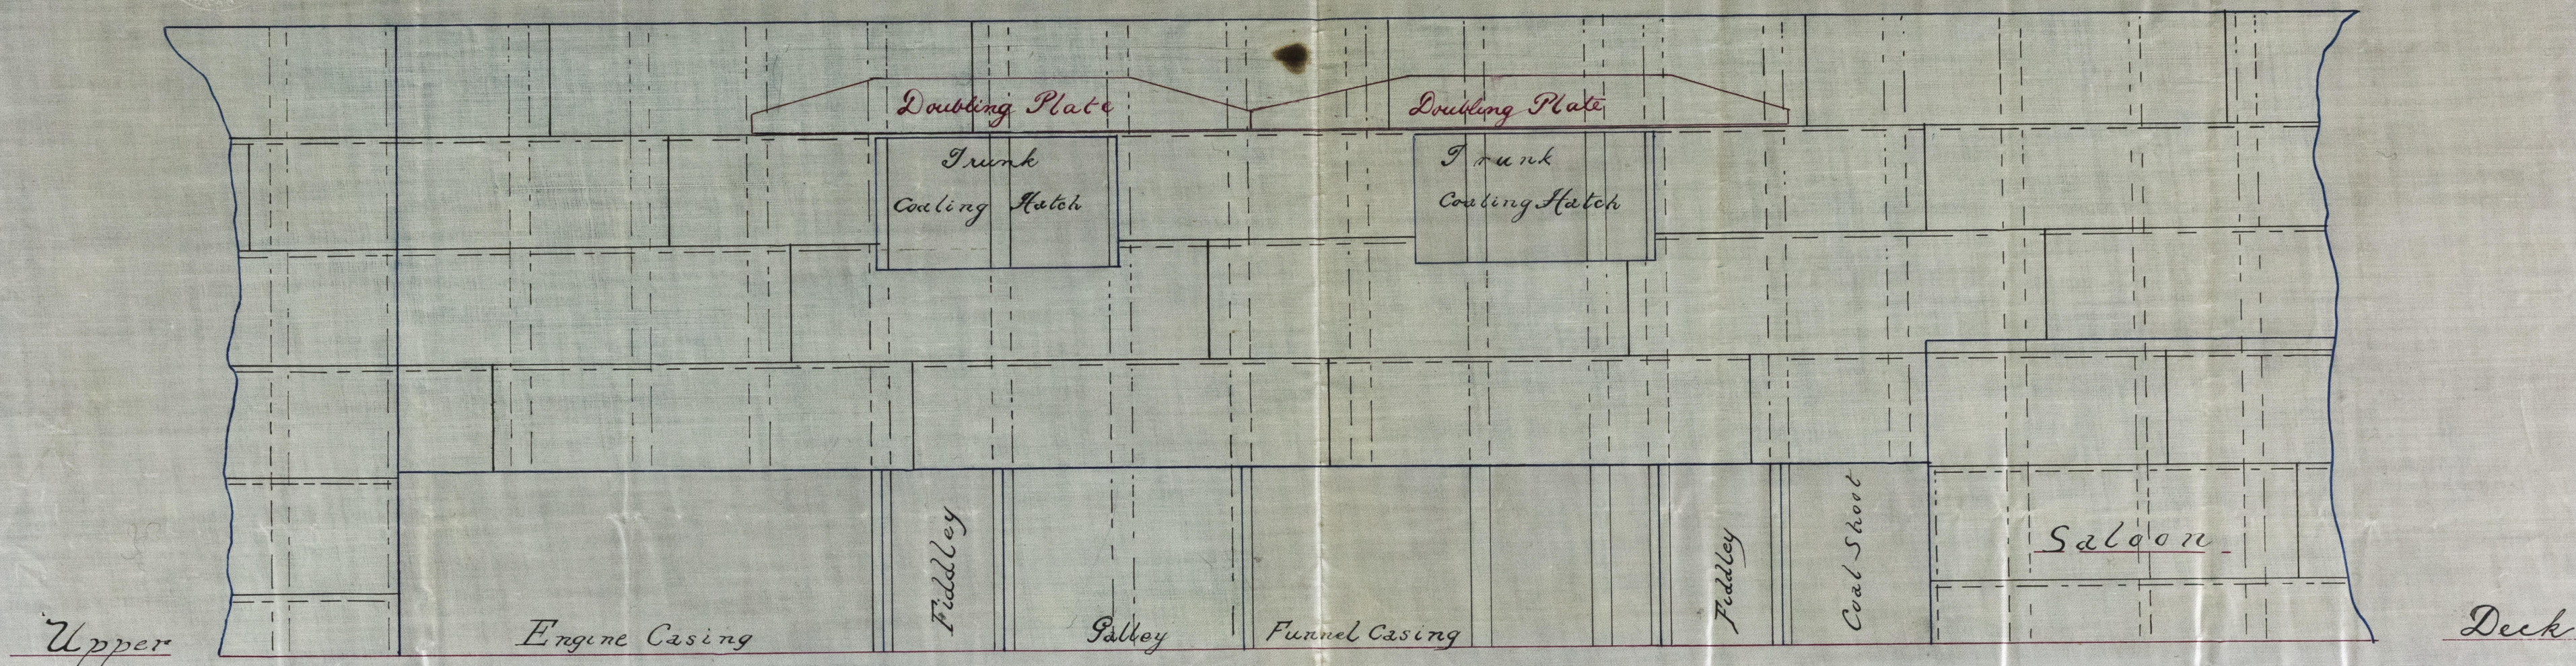

J. H.
26/11/83

Note This, and the accompanying elevation are the tracings referred to in a foot note on the longitudinal section submitted on the 21st September.

J. 24.11.83

WORKMAN, CLARK & CO., LIMITED
SHIPBUILDERS
NOV 22 1883
ENGINEERS
BELFAST

Lloyd's Register
Foundation