


Lt. J. B. Bel:  
30/1/84.

Plan of Masts No. 25. I. S. P. "River Endus"  
To Class 100 A. 1  
Scale 1/2" inch = one foot  
Belfast Report  
No. 3105

 


Fore Mast

Main Mast

Note: The Foremast is square rigged the main mast is  
Barque rigged: The foremast is reduced as it is specified in Tables  
for shauers: The main mast is reduced 1/5th for barque rig & 1/5th for  
shauers: all as stated in Table & similar. ~~As per No. 7 S. P.~~  
~~This is not the case J.B.~~

J.B.B.  
30/1/84

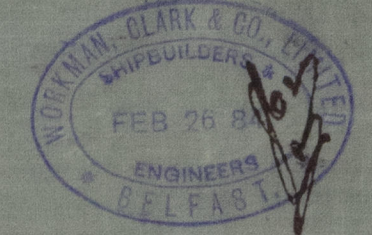

Lloyd's Register  
Foundation