

The words FORGINGS or CASTINGS, IRON or STEEL, should be struck out as may be required.

Received at Belfast Office, Oct. 29th 1884

Lloyd's Register of British and Foreign Shipping.

(Report on Vessel No. 23 Port Belfast)

No. 911

SHIP FORGINGS OR CASTINGS.

I have to report that the undermentioned Iron ~~or Steel~~ Forgings ~~or Castings~~, manufactured by Messrs I & W. Beardmore of Glasgow for the Vessel No. 23, being built by Messrs McIlwaine, Lewis & Co of Belfast have been inspected by me as set forth below, and found to be, so far as can be seen, sound and efficient

Mark on Forgings.

Lloyd's

No. 911

G. N.


George Newcomb

Glasgow

28/10/84.

	STERN FRAME.	RUDDER FRAME.	STEM.
Material* - - - -		<u>Scrap iron</u>	
How made - - - -		<u>Forged</u>	
Dimensions - - - -		<u>3 3/4 to 2 1/4</u>	
Progress on Inspection -		<u>Forged and smithed</u>	
Dates when Inspected		<u>2.9.11.17.25/10/84.</u>	

SKETCHES OF FRAMES SHEWING POSITION AND DESCRIPTION OF WELDS OF FORGINGS, OR PARTICULARS OF TESTS APPLIED TO CASTINGS.

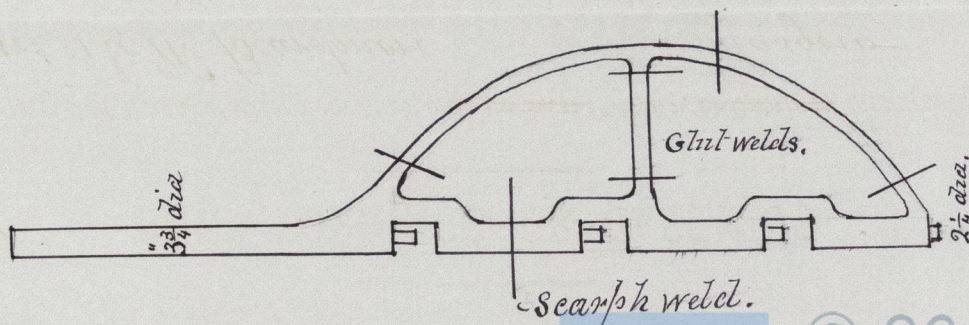

© 2019

Lloyd's Register
Foundation

* If of Iron, state whether scrap or puddled Iron.

S. S. Monarch
Belfast Report
No 3111



© 2019

Lloyd's Register
Foundation