


Laing 101447

S.S. No. 23.

'Monarch' Belfast Report  
No. 3171

Str. to Bel  
14/8/84.

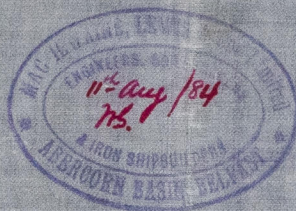

155'-0" x 22'-6" x 11'-4 1/2" top of floors

30 Class 100 A at Lloyd's

Scale 1/2" = one foot.

6.84 Breadths

12.44 Depths.

Half Lirth 21.16

Breadth 11.25

Depth 12.45

44.86 = 1 1/2

154

17944

22430

4486


6908.44 = 2 7/8

460

7368 = Equip. 10

1/8 added

Unenclosed Bridge & Forecastle.

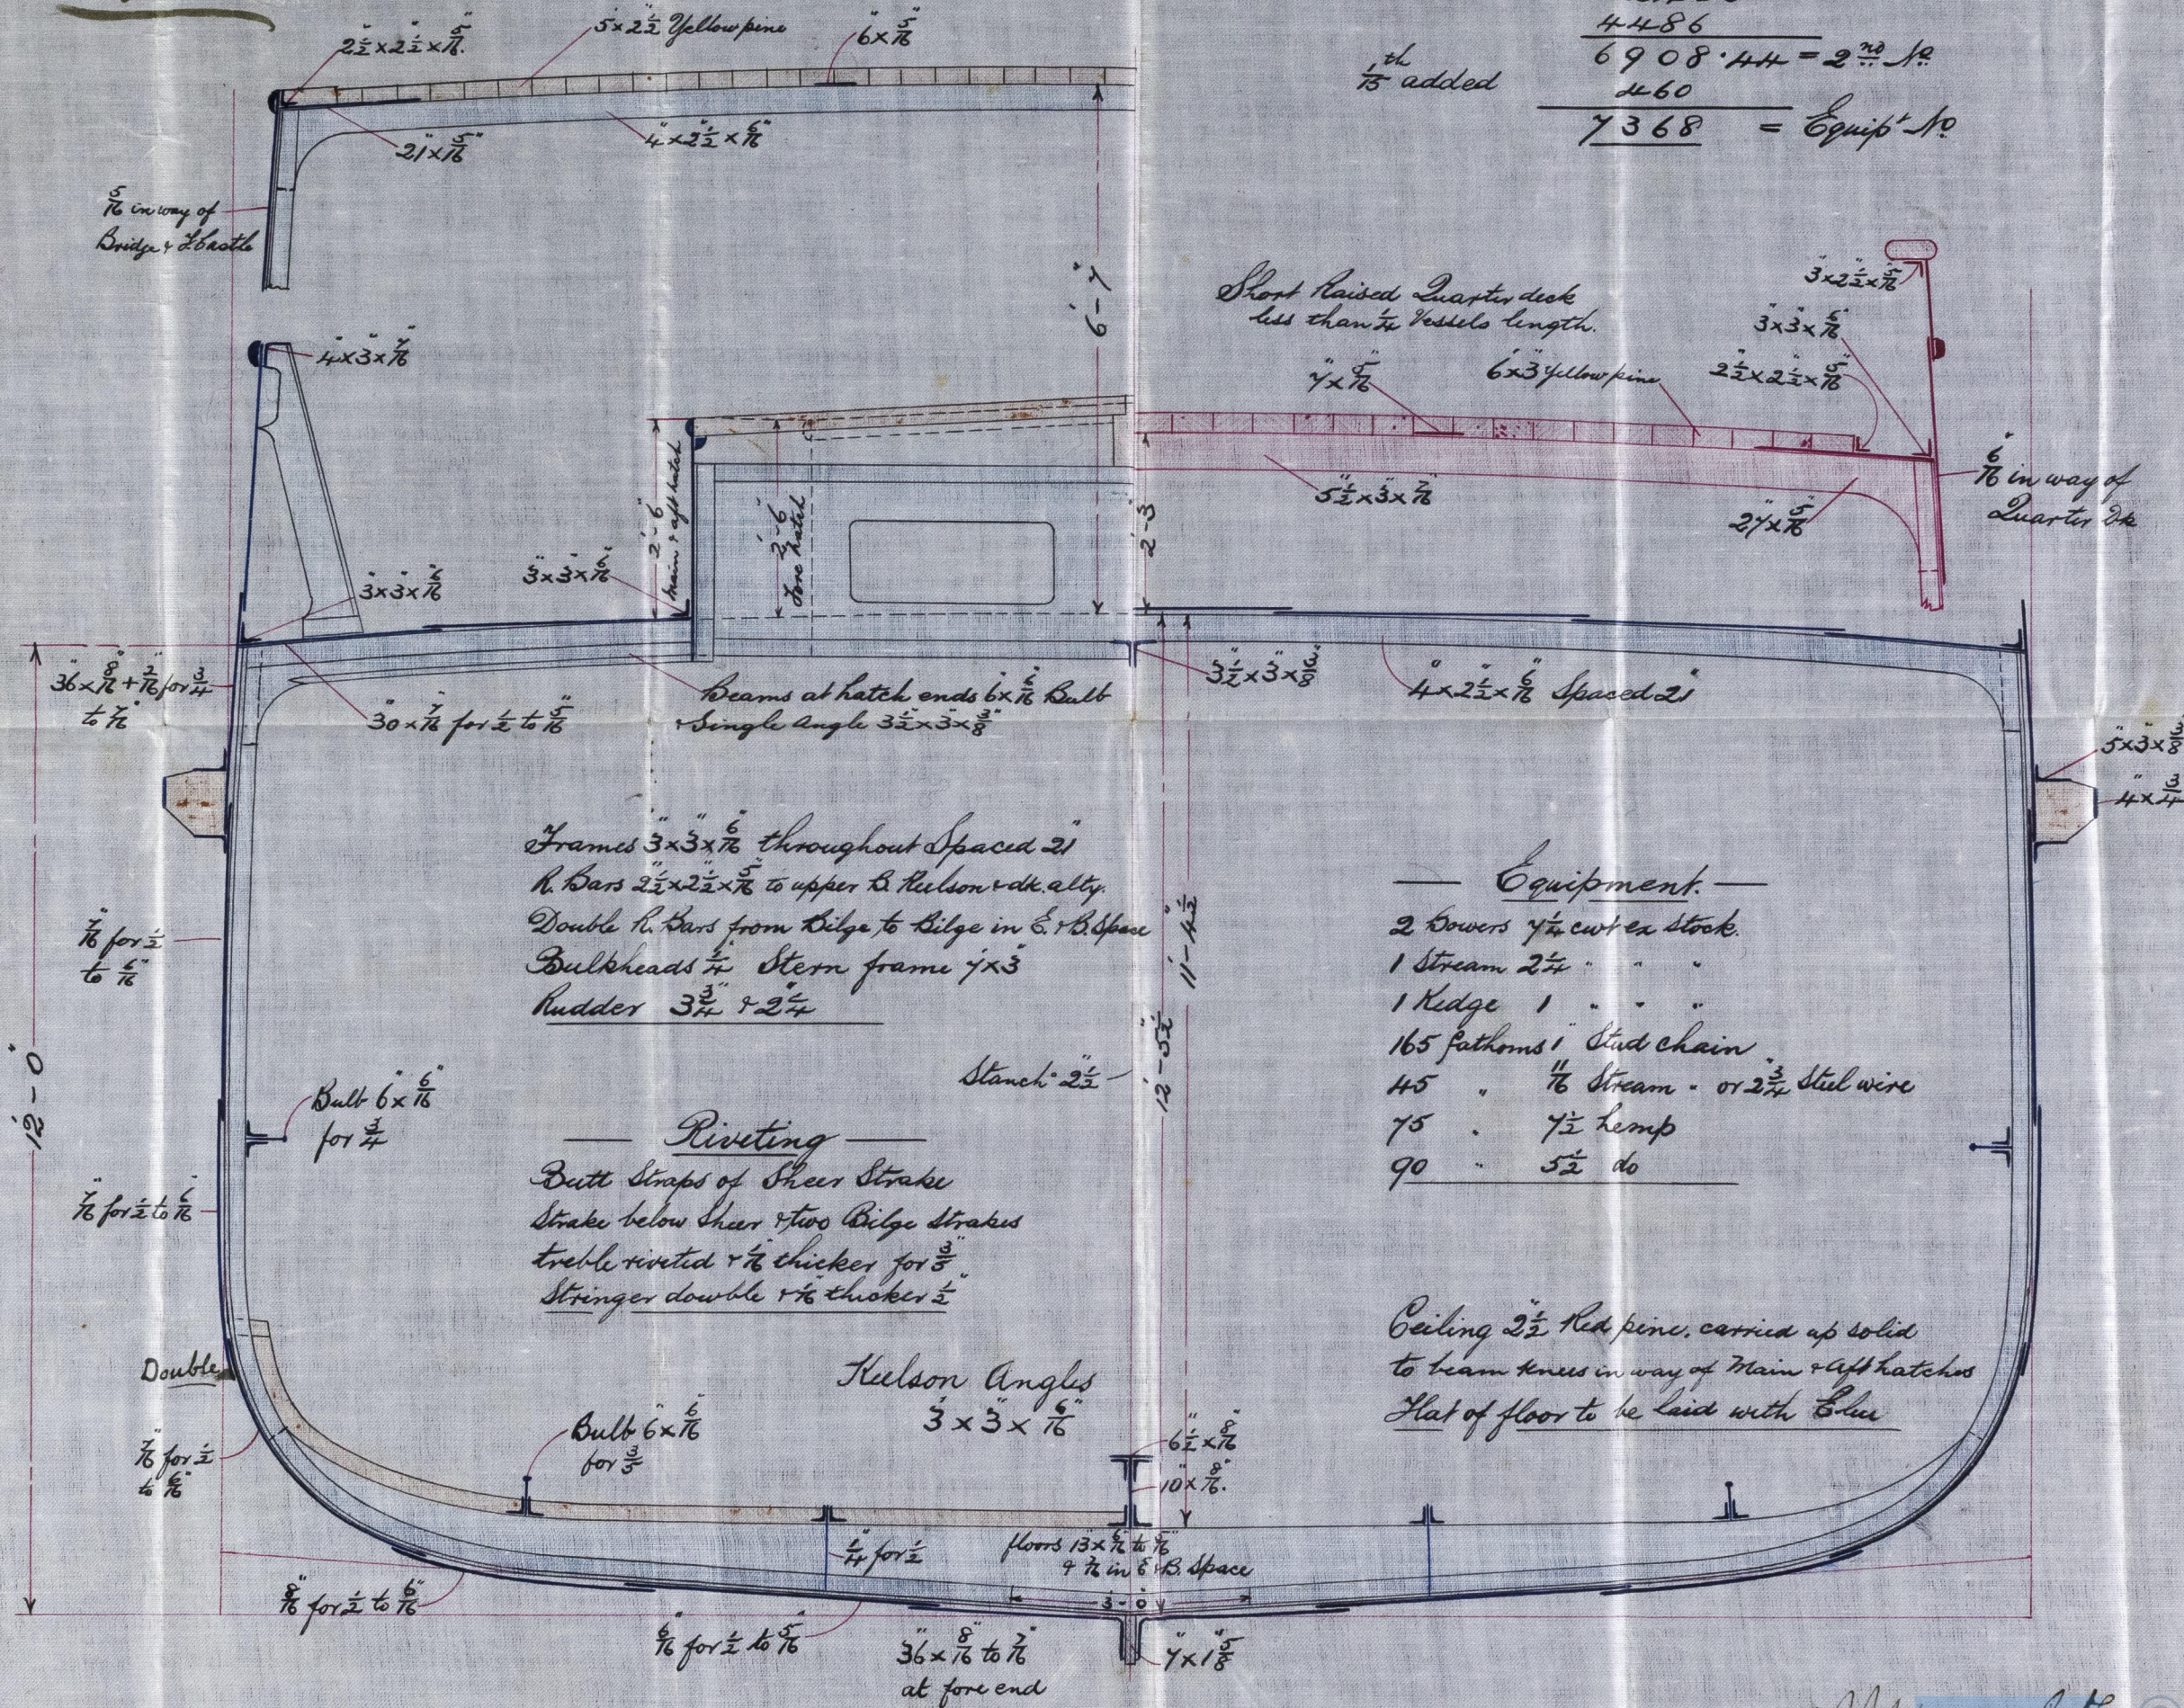

Short Raised Quarter deck  
less than the vessel's length.

1/4 x 1/8

6 x 3 yellow pine

2 1/2 x 2 1/2 x 1/8

3 x 2 1/2 x 1/8

3 x 3 x 1/8

1/8 in way of  
Quarter Deck

5 1/2 x 3 x 1/8

2 1/2 x 1/8

Beams at hatch ends 6 x 1/8 Bulb  
Single angle 3 1/2 x 3 x 3/8

Frames 3 x 3 x 1/8 throughout Spaced 2'  
Double R. Bars from Bilge to Bilge in E. & W. Space  
Bulkheads 1/2 Stern frame 7 x 3  
Rudder 3 1/2 x 2 1/4

Stanchion 2 1/2

Riveting

Butt Straps of Sheer Strake  
Strake below Sheer & two Bilge Strakes  
treble riveted & 1/2 thicker for 3/4  
Stringer double & 1/2 thicker for 1/2

3 x 3 x 1/8

Bulb 6 x 1/8  
for 3/4

Equipment.

- 2 Bowers 1/4 cut ex stock.
- 1 Stream 2 1/4
- 1 Ridge 1
- 165 fathoms 1/2 Stud chain
- 45 1/8 Stream or 2 1/4 Steel wire
- 75 1/2 hemp
- 90 5/2 do

Ceiling 2 1/2 Red pine, carried up solid  
to beam knees in way of Main & aft hatches  
Flat of floor to be laid with Blue