

TRACING N°1528




## FOR

SHIP N<sup>o</sup> 24.

All steel plates. Pressure 85 lbs.  
All holes drilled in place after bending.

Nº 213.

DR  
Bris, 8/11/04

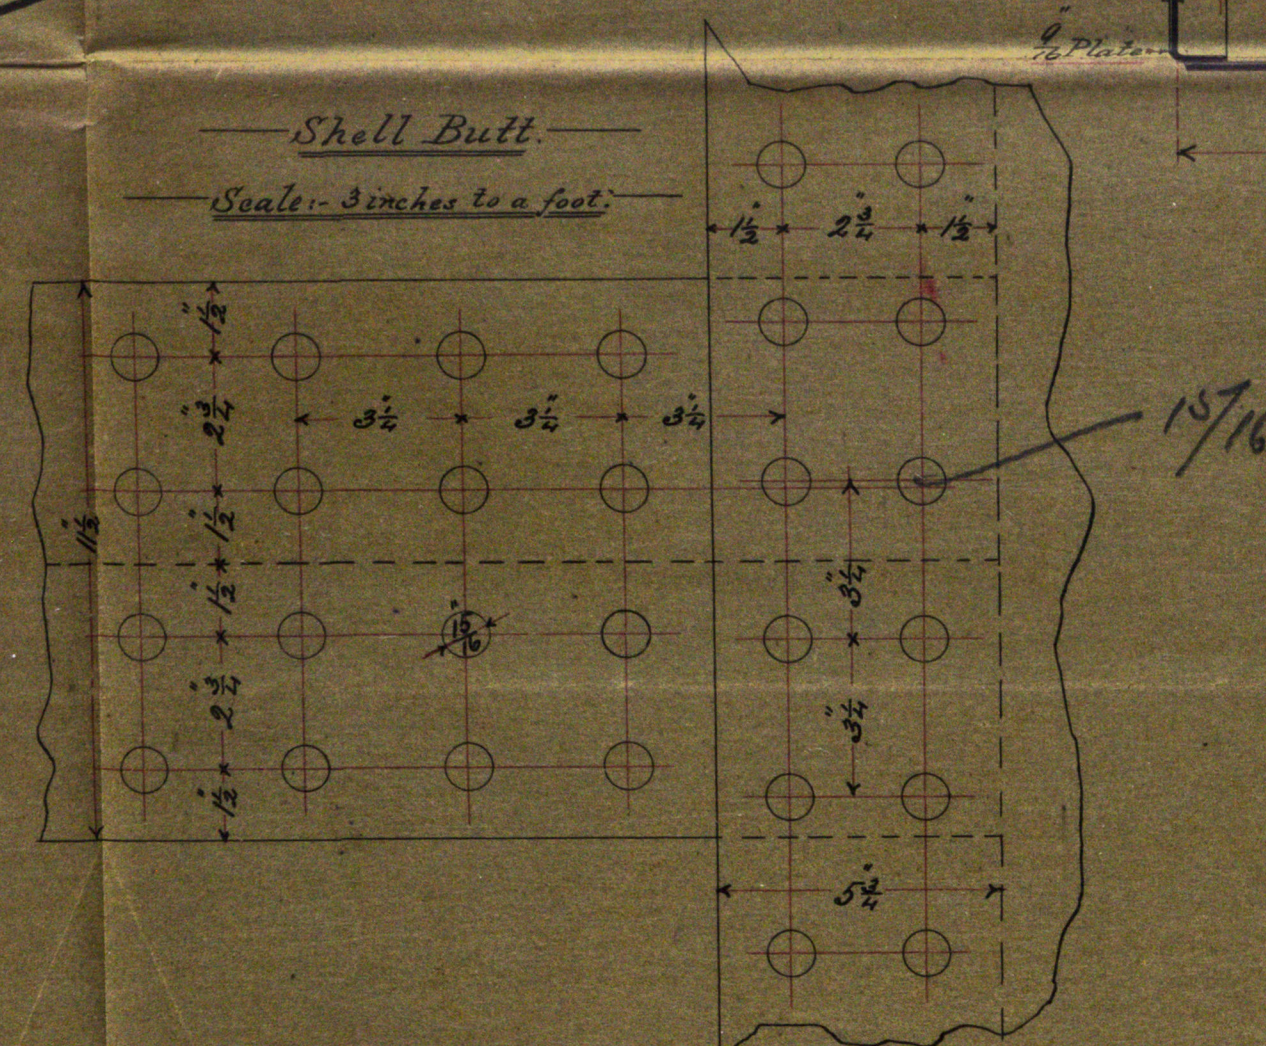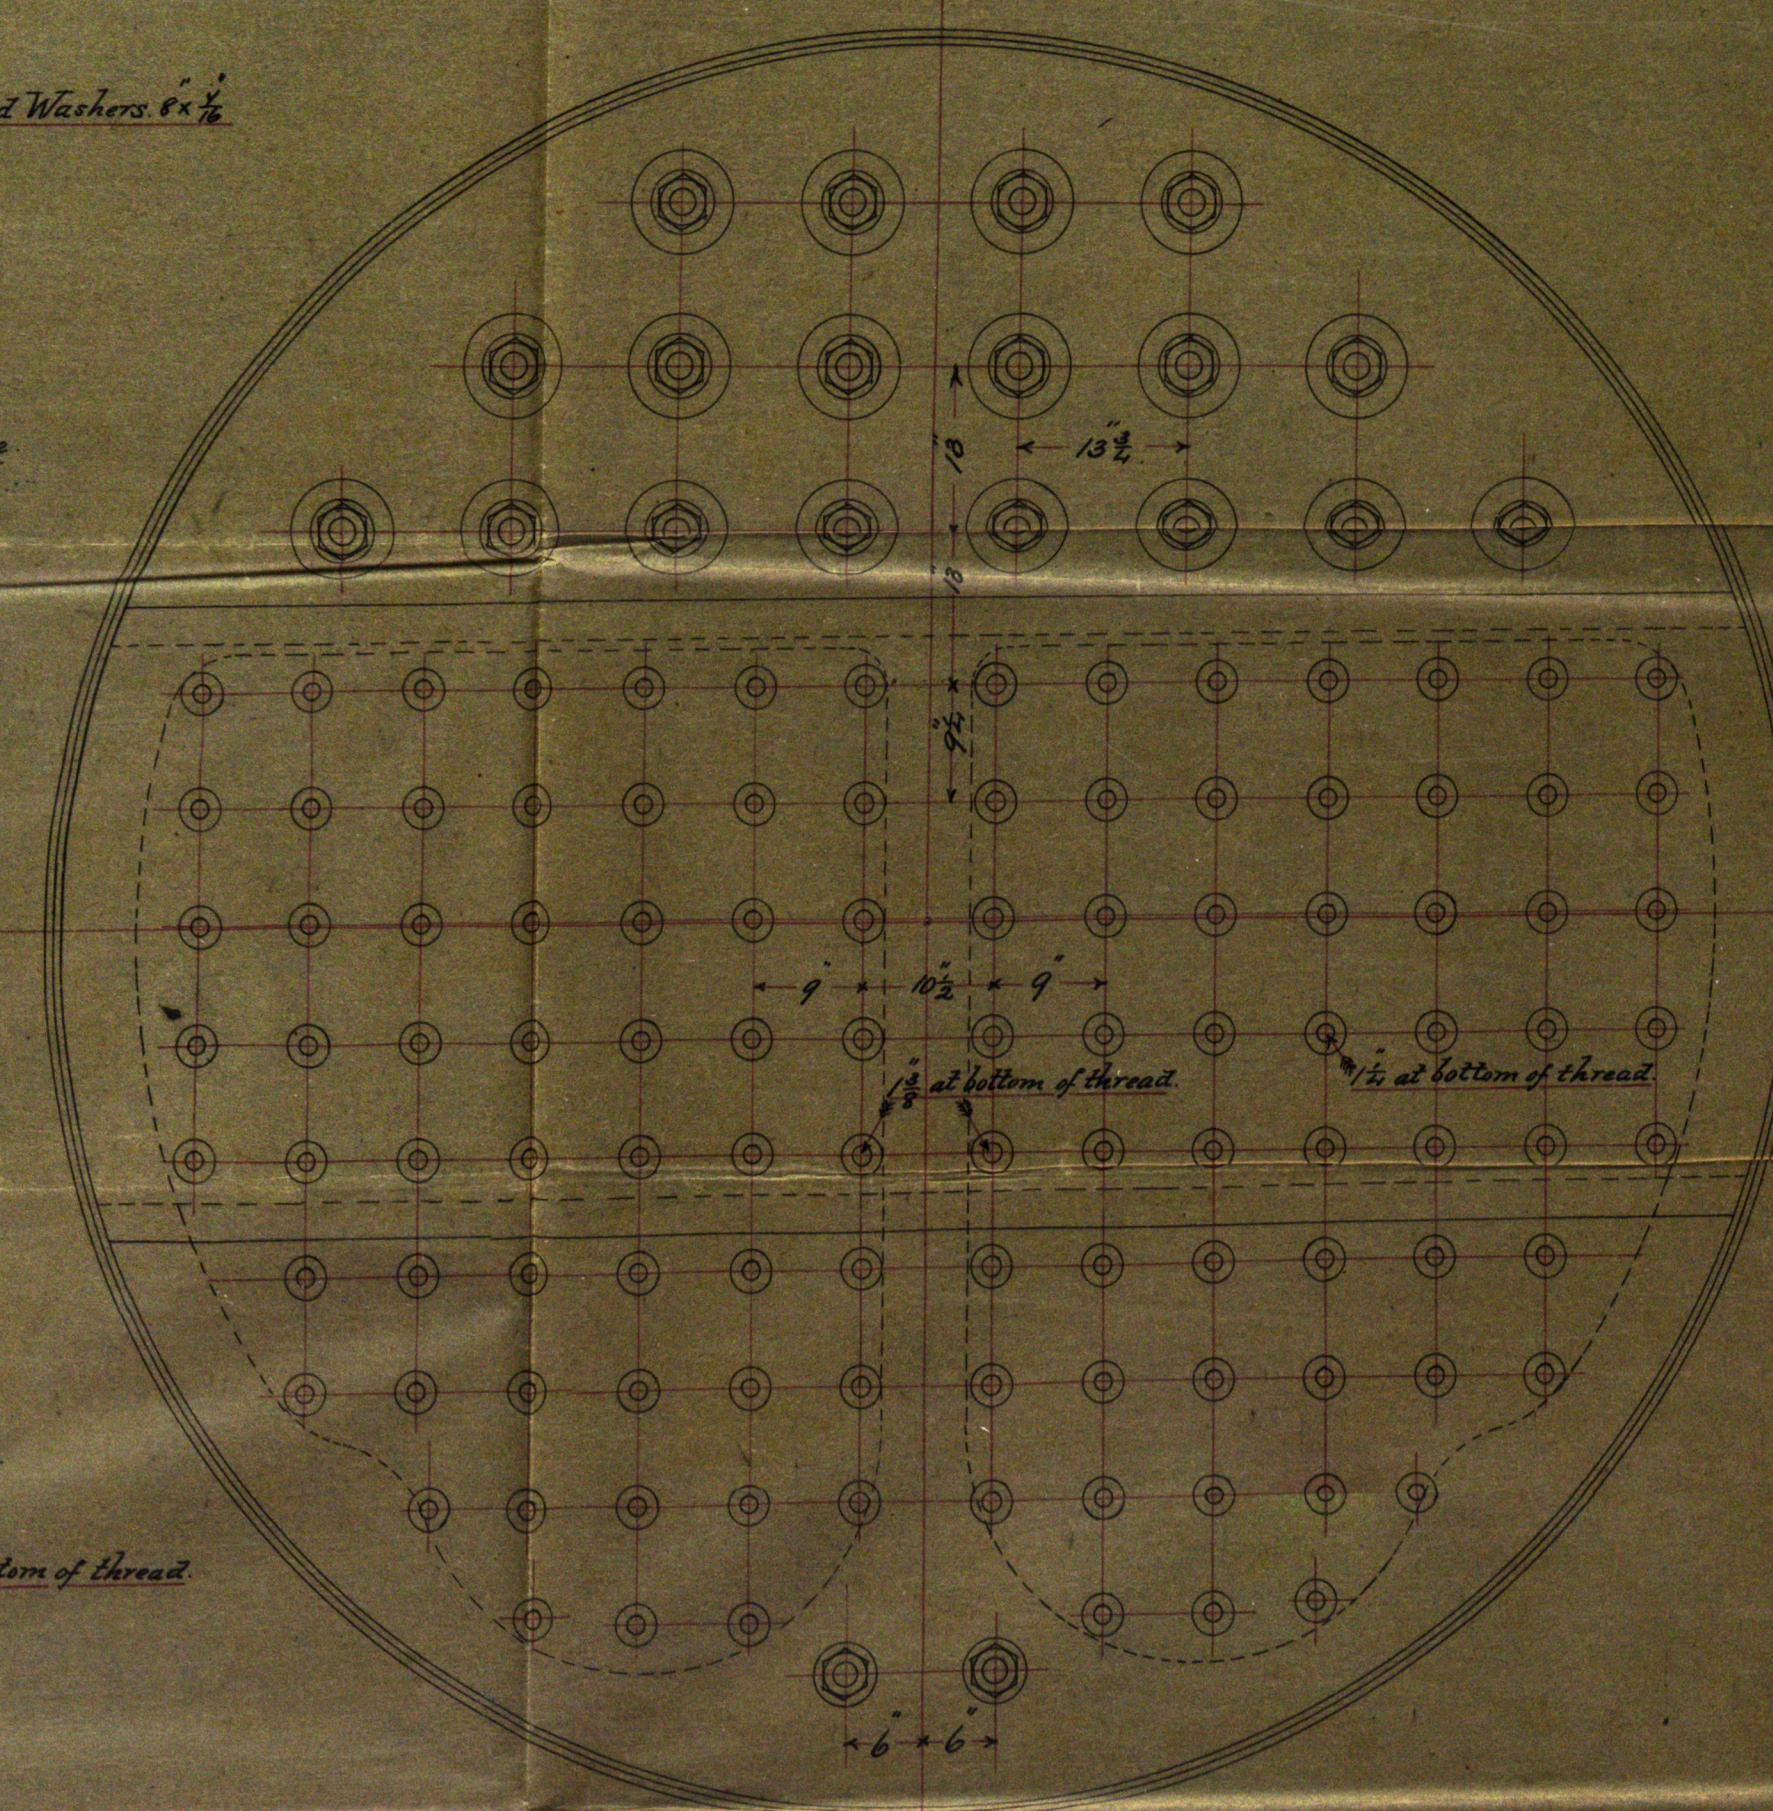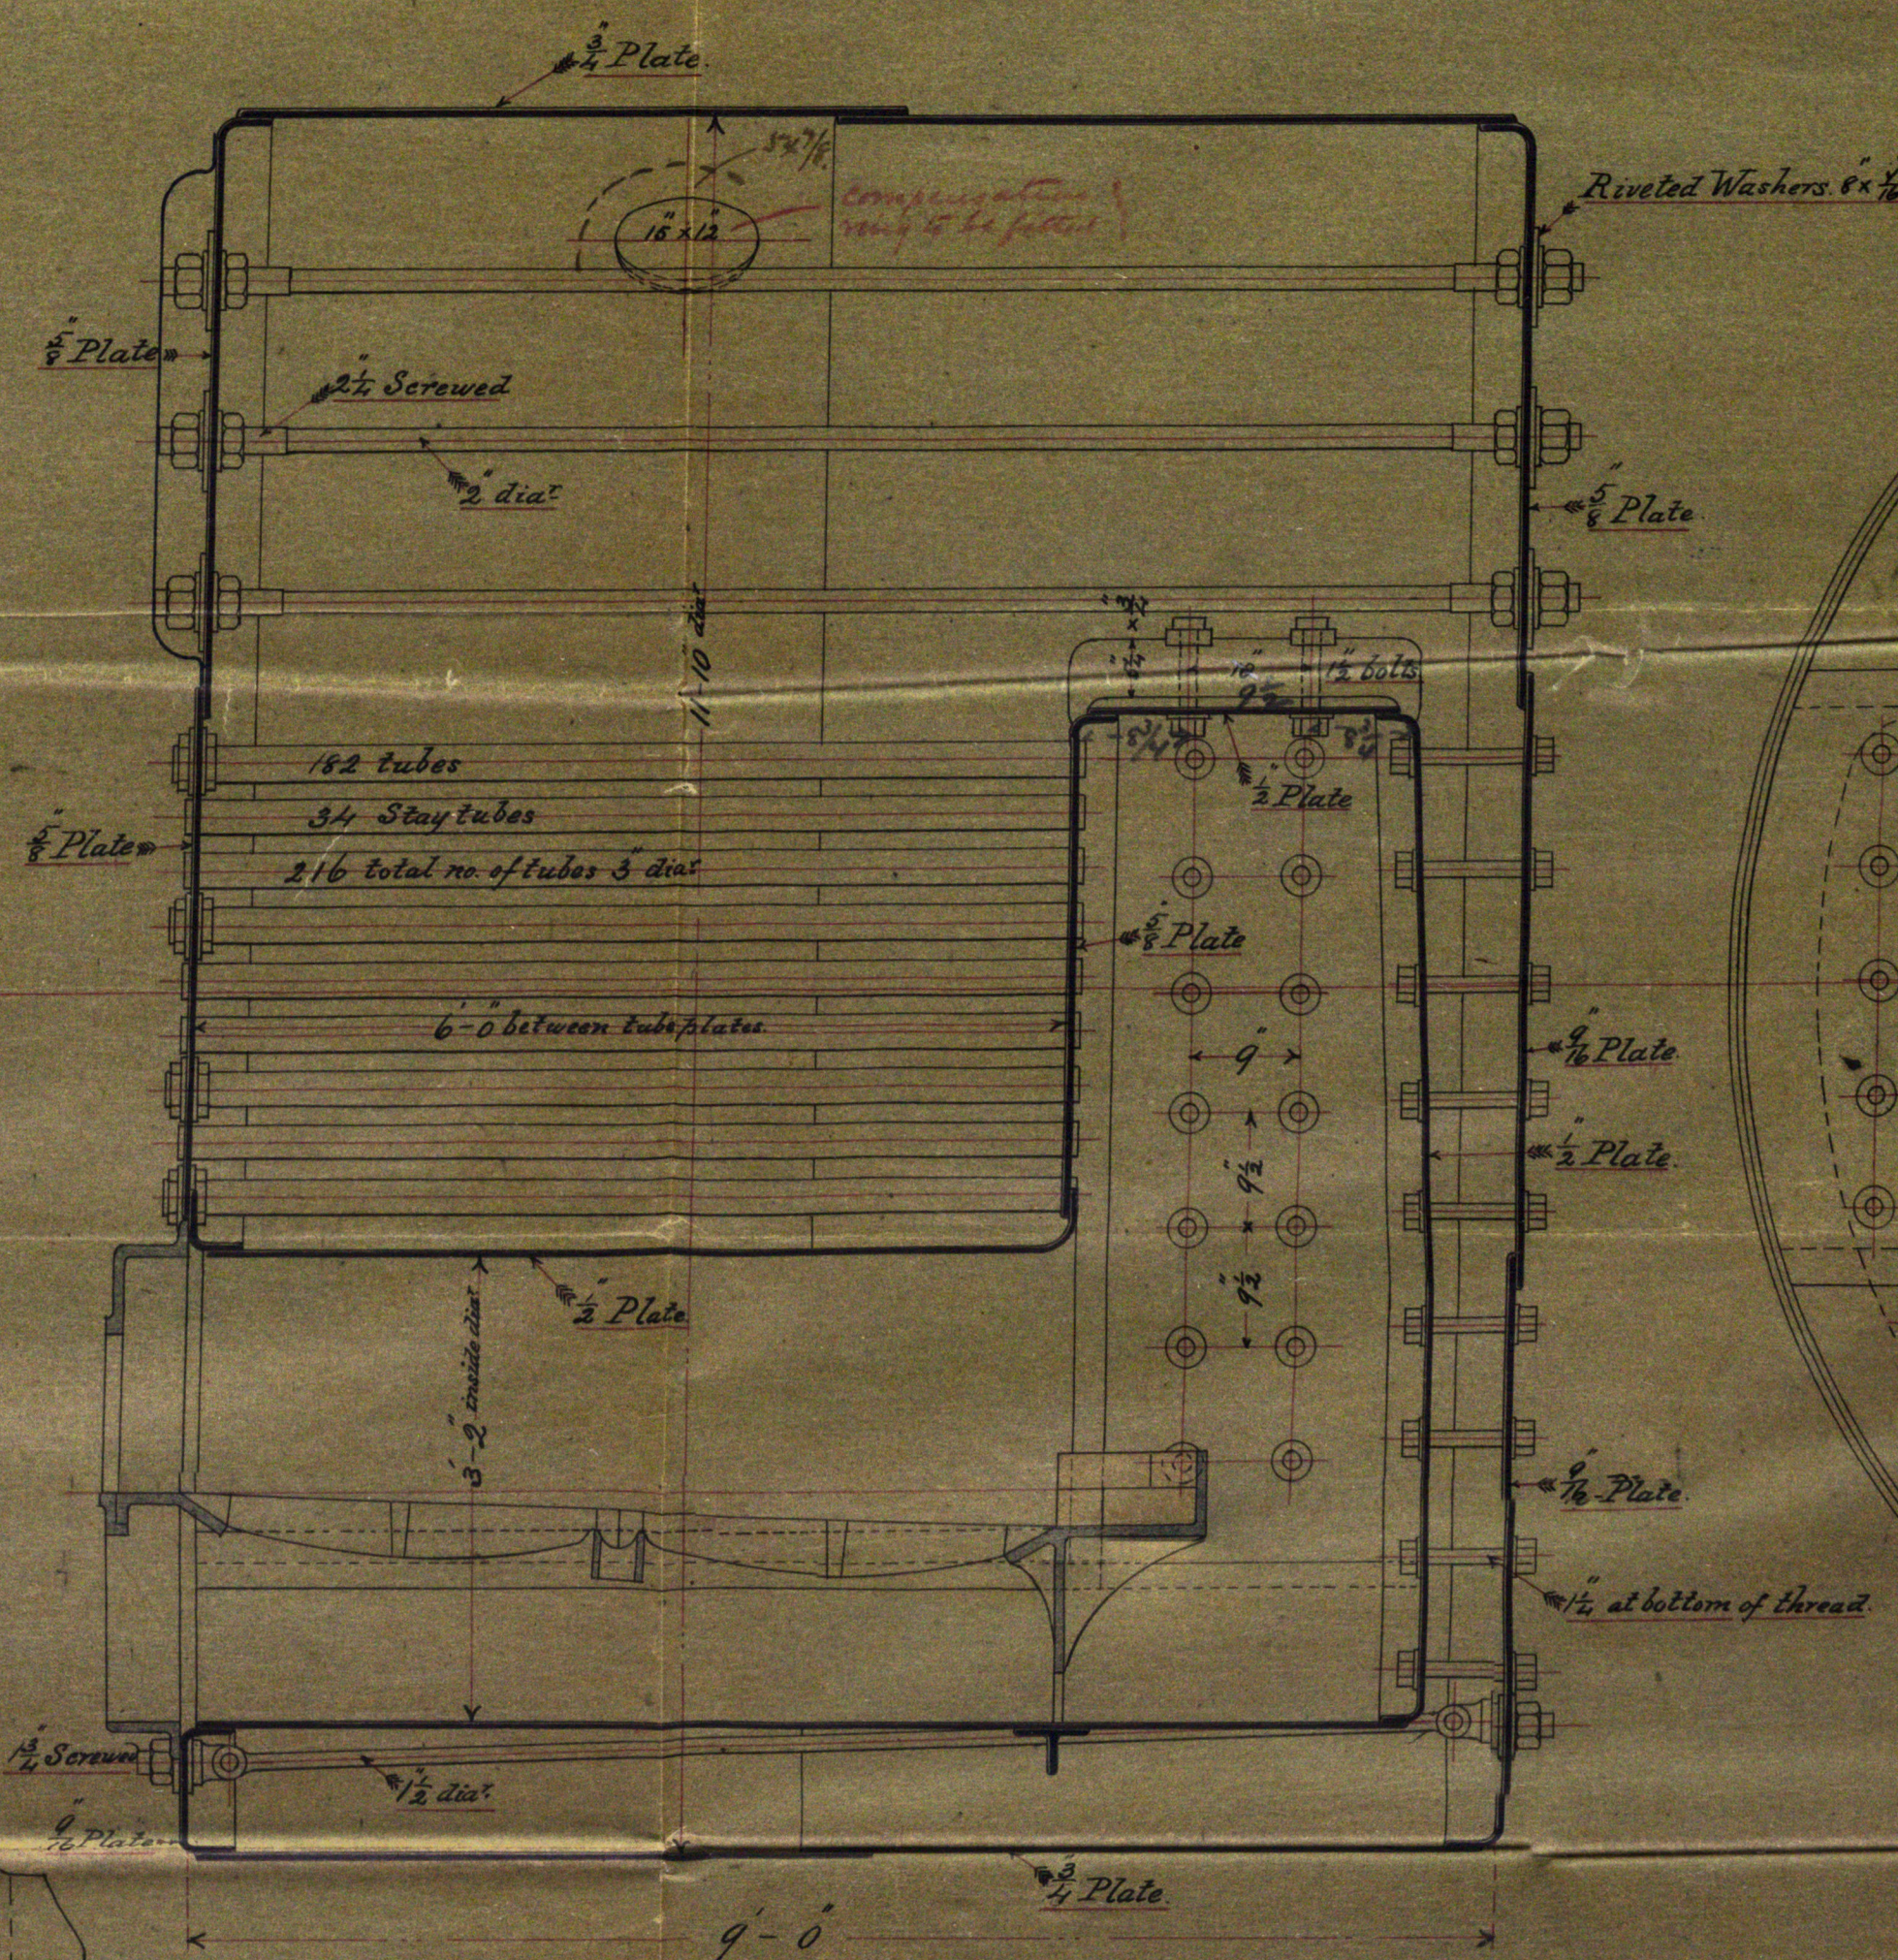

SCALE  $\frac{3}{4}$  INCH TO A FOOT.

D. J.  
11/11/84

BEL53-0094