

L^{ts}: H Bel.
 25/10/84.

S. L. Lady Arthur Hall

Belfast Report No 3150

S. S. N^o 24.

150'-0" x 23'-0" x 10'-11" top of floors

To Class 100A at Lloyds

Scale $\frac{1}{2}'' = \text{one foot}$

6.48 Breadths

12.25 Depths

Short Raised Quarter Deck & Enclosed T^g_{II} F^{lt} Castle

Half Girth 21.2

" Breadth 11.5

Depth 12.16

$$44.86 = 1^{\text{st}} N^{\circ}$$

149


40374

17944

4486

$$\frac{1}{10} \frac{d}{dt} (6684.14) = 2^{\text{nd}} \text{ } N^{\circ}$$
$$\begin{array}{r} 008 \\ \hline 7352 \end{array}$$

27th Oct 1894
MS.

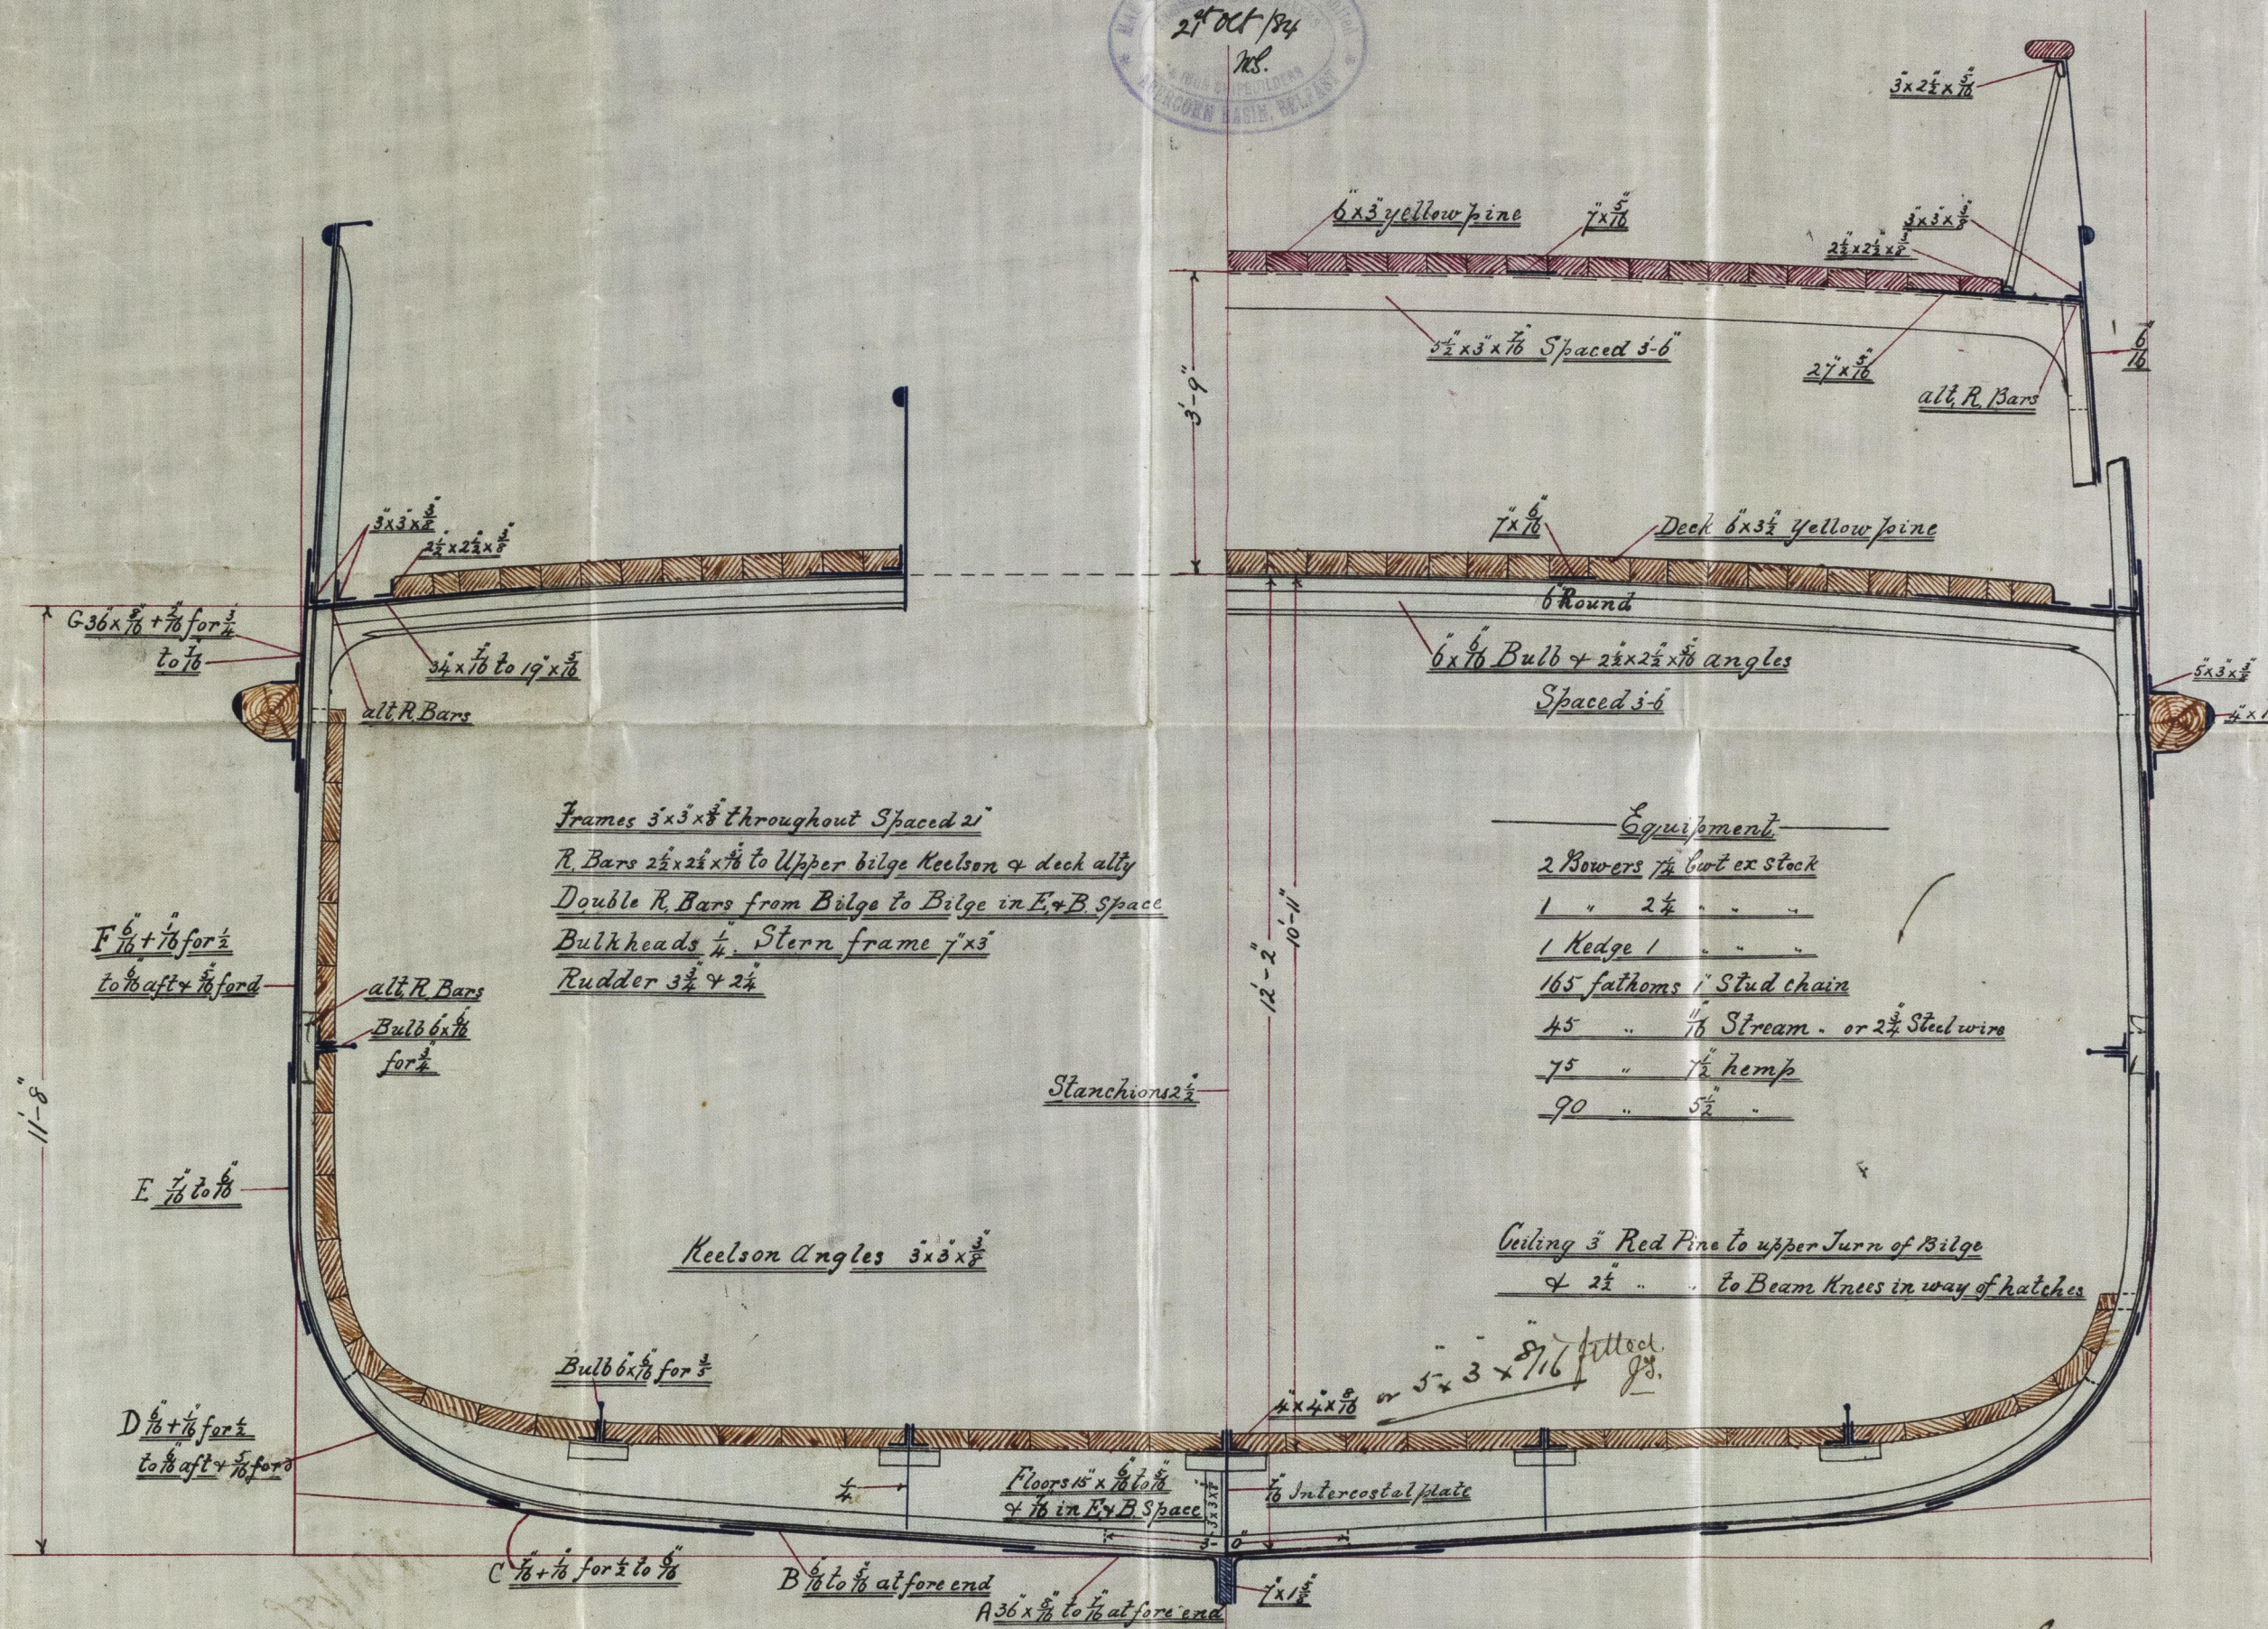

J.V.P.
257/10/84

22.10.84

Lloyd's Register
Foundation

BEL 53-0100