

The words FORGINGS or CASTINGS, IRON or STEEL, should be struck out as may be required.

Received at Belfast Office, May 27<sup>th</sup> 1885

# Lloyd's Register of British and Foreign Shipping.

(Report on Vessel No. 30 Port Belfast)  
S.S. City of Bombay Report No 3143

## No. 155.A. SHIP FORGINGS OR CASTINGS.

I have to report that the undermentioned Iron or ~~Steel~~ Forgings or Castings, manufactured by The Darlington Forge Co. of Darlington for the Vessel No. 30, being built by Wm. Rankin & Co. of Belfast have been inspected by me as set forth below, and found to be, so far as can be seen, sound and efficient.


Mark on Forgings.

**Lloyd's**  
 No. 155.A.  
156.

Hugh Cameron.  
Sunderland.

	STERN FRAME.	RUDDER FRAME.	STEM.
Material*	<u>Scrap Iron</u>	<u>Scrap Iron</u>	/
How made	<u>Forged</u>	<u>Forged</u>	
Dimensions	<u>11' x 4 1/2"</u>	<u>9 1/2" - 4 1/2"</u>	
Progress on Inspection	<u>Forged &amp; Smithed</u>	<u>Forged &amp; Smithed</u>	
Dates when Inspected	<u>Sept 12-18-25 Oct 6-10-15</u> <u>24-31 Nov 5-18-22/84</u>	<u>Oct 18-15-22-29 Dec 11-18</u> <u>24-31/84 Jan 3-19-26 Feb 6-14</u> <u>26-March 16 May 2-6-13/85</u>	

SKETCHES OF FRAMES SHEWING POSITION AND DESCRIPTION OF WELDS OF FORGINGS, OR PARTICULARS OF TESTS APPLIED TO CASTINGS.

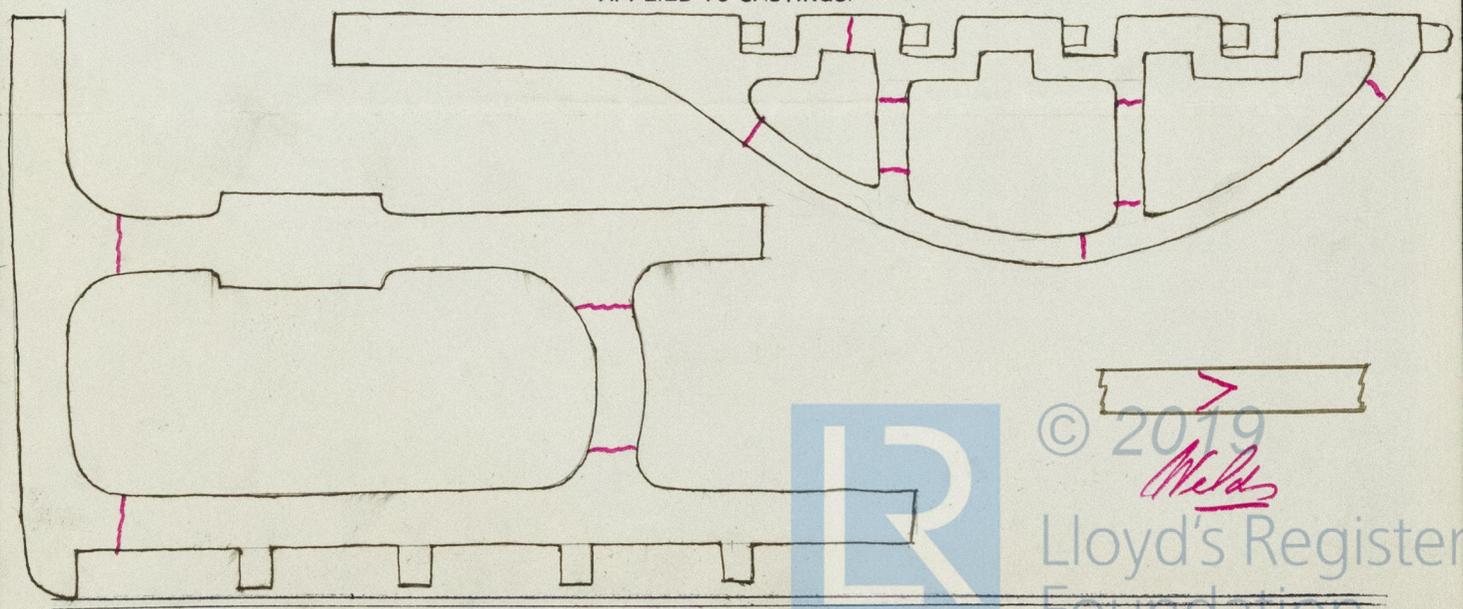

© 2019  
 Welds  
 Lloyd's Register  
 Foundation

\* If of Iron, state whether scrap or puddled Iron.