


St. to Bel.
8/8/84.


— Proposed Compensation for cutting Lower Deck Stringer in Boiler Room —

— 8th 30 S. S. — "City of Bombay"

— Scale $\frac{1}{4}$ inch = one foot — Belfast Report No. 3173

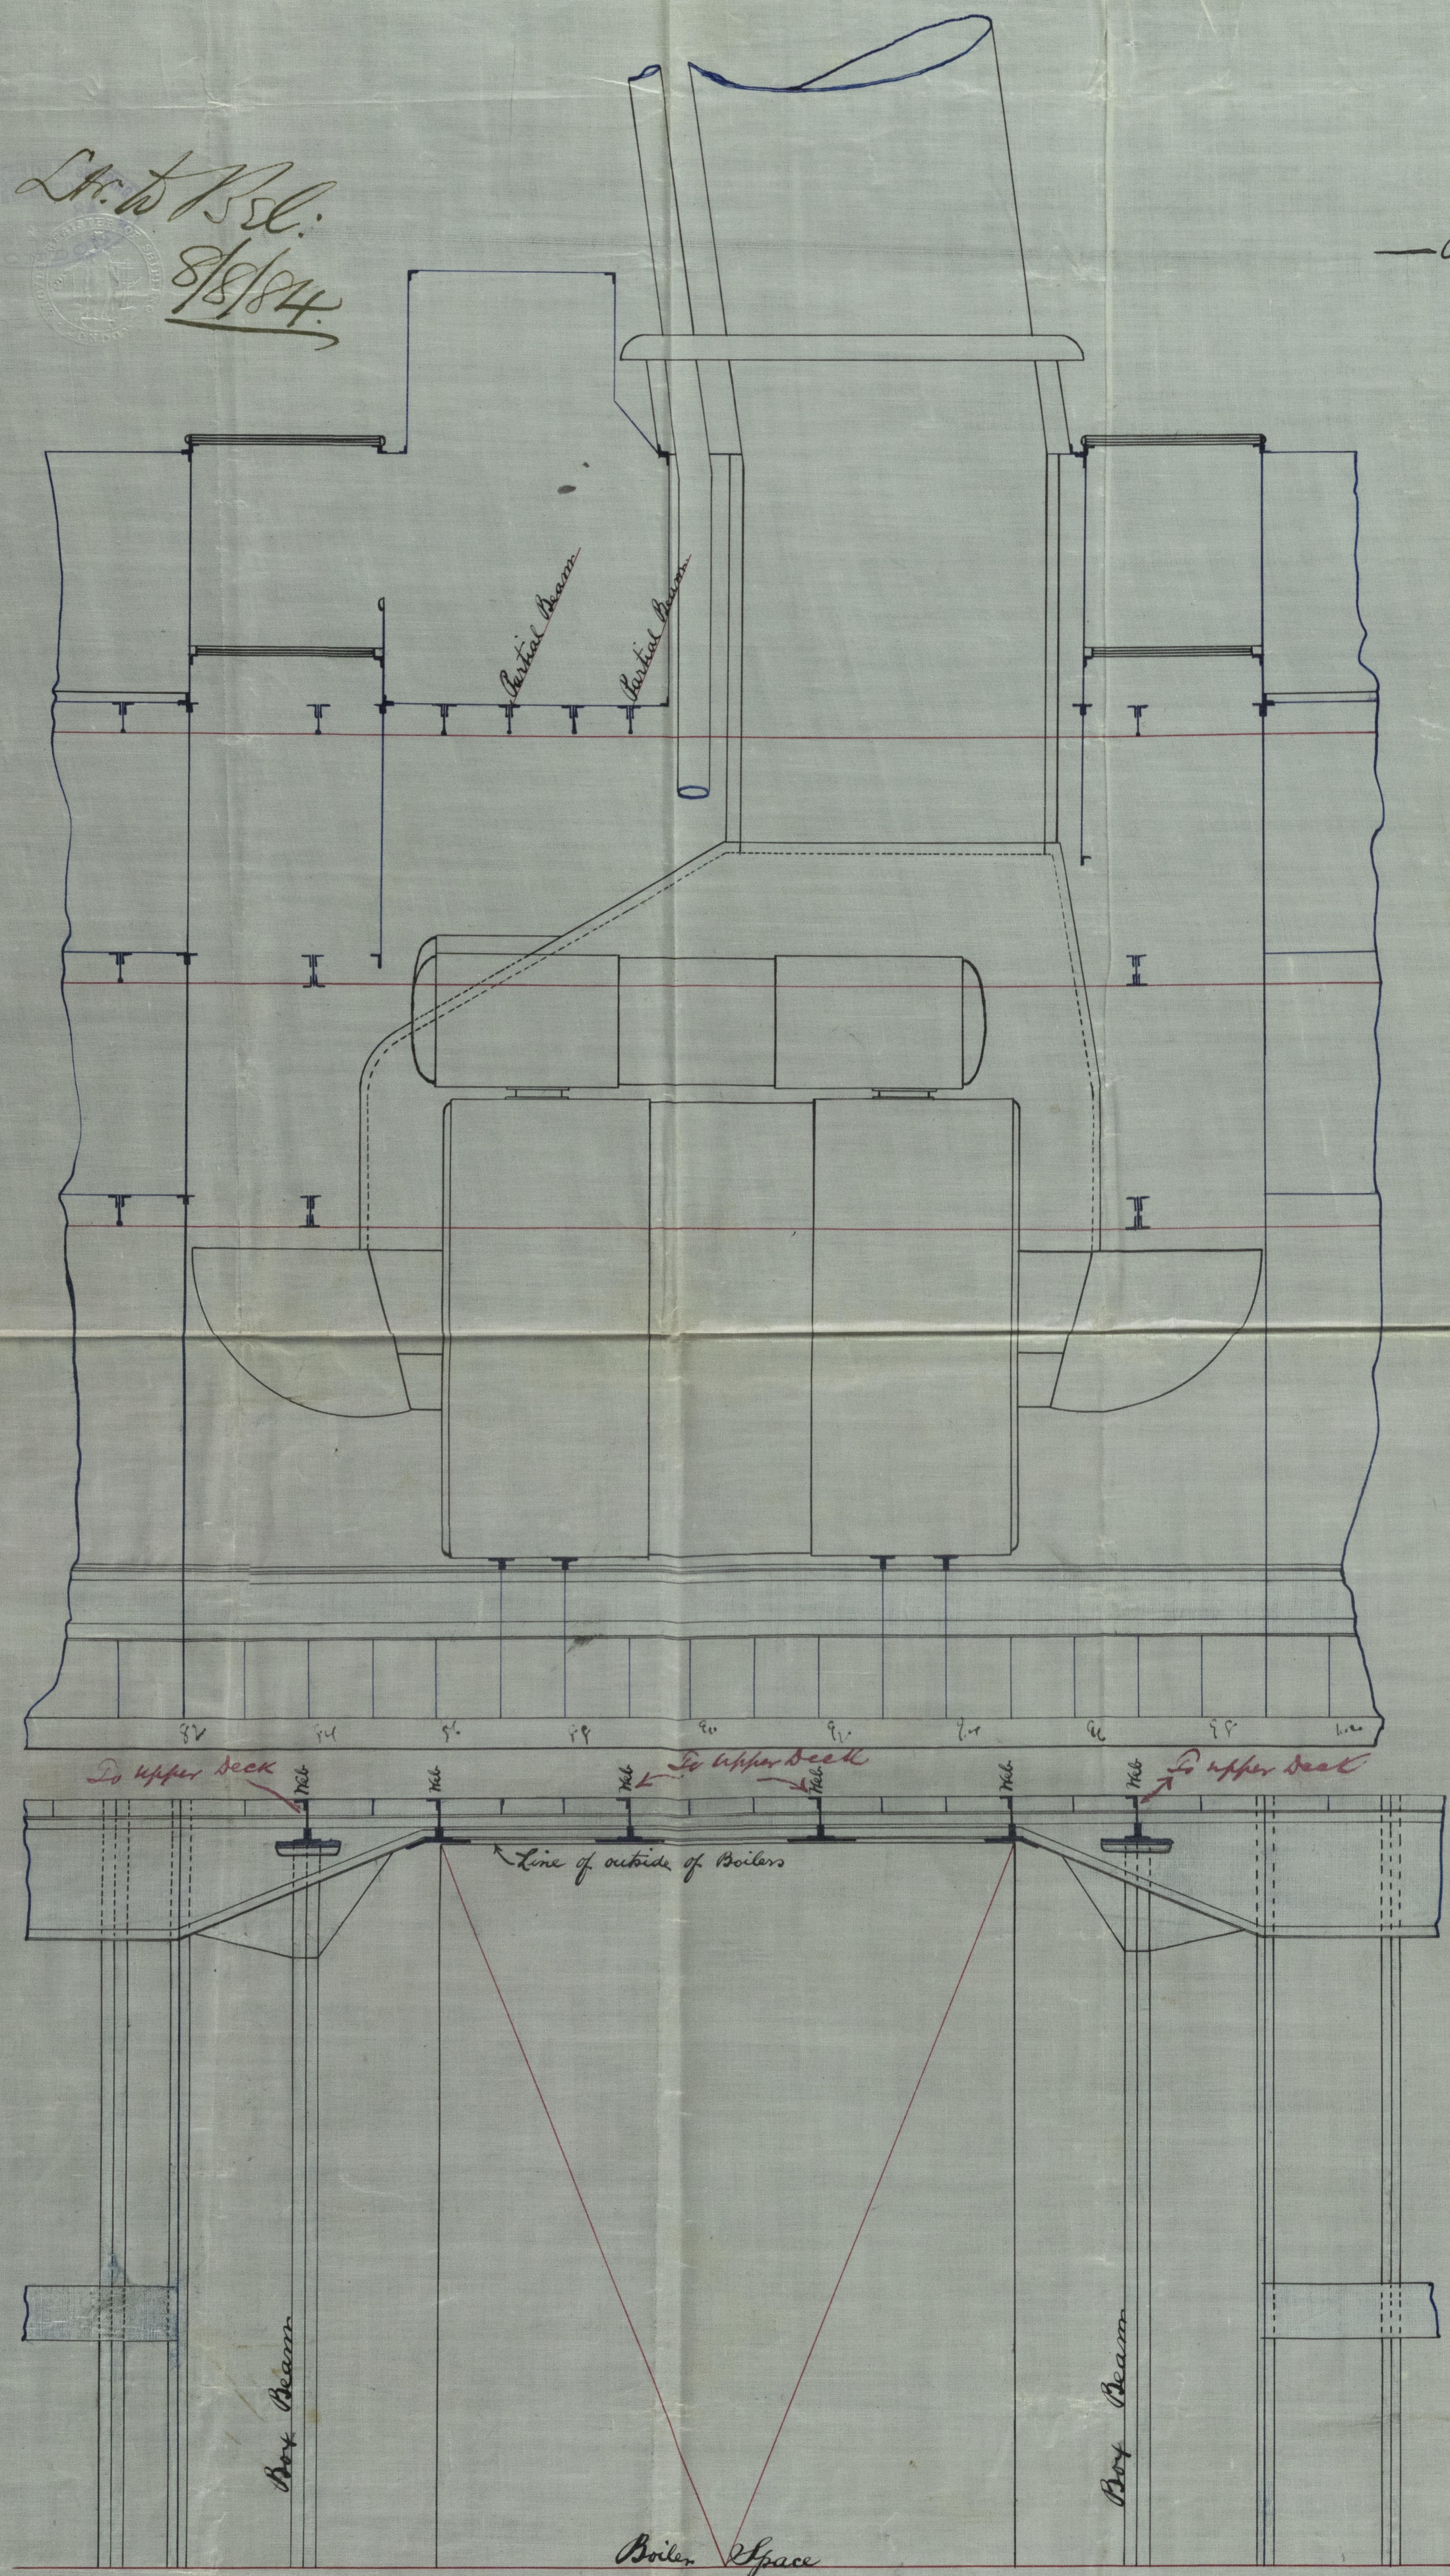

— Boiler space No. Frames. —

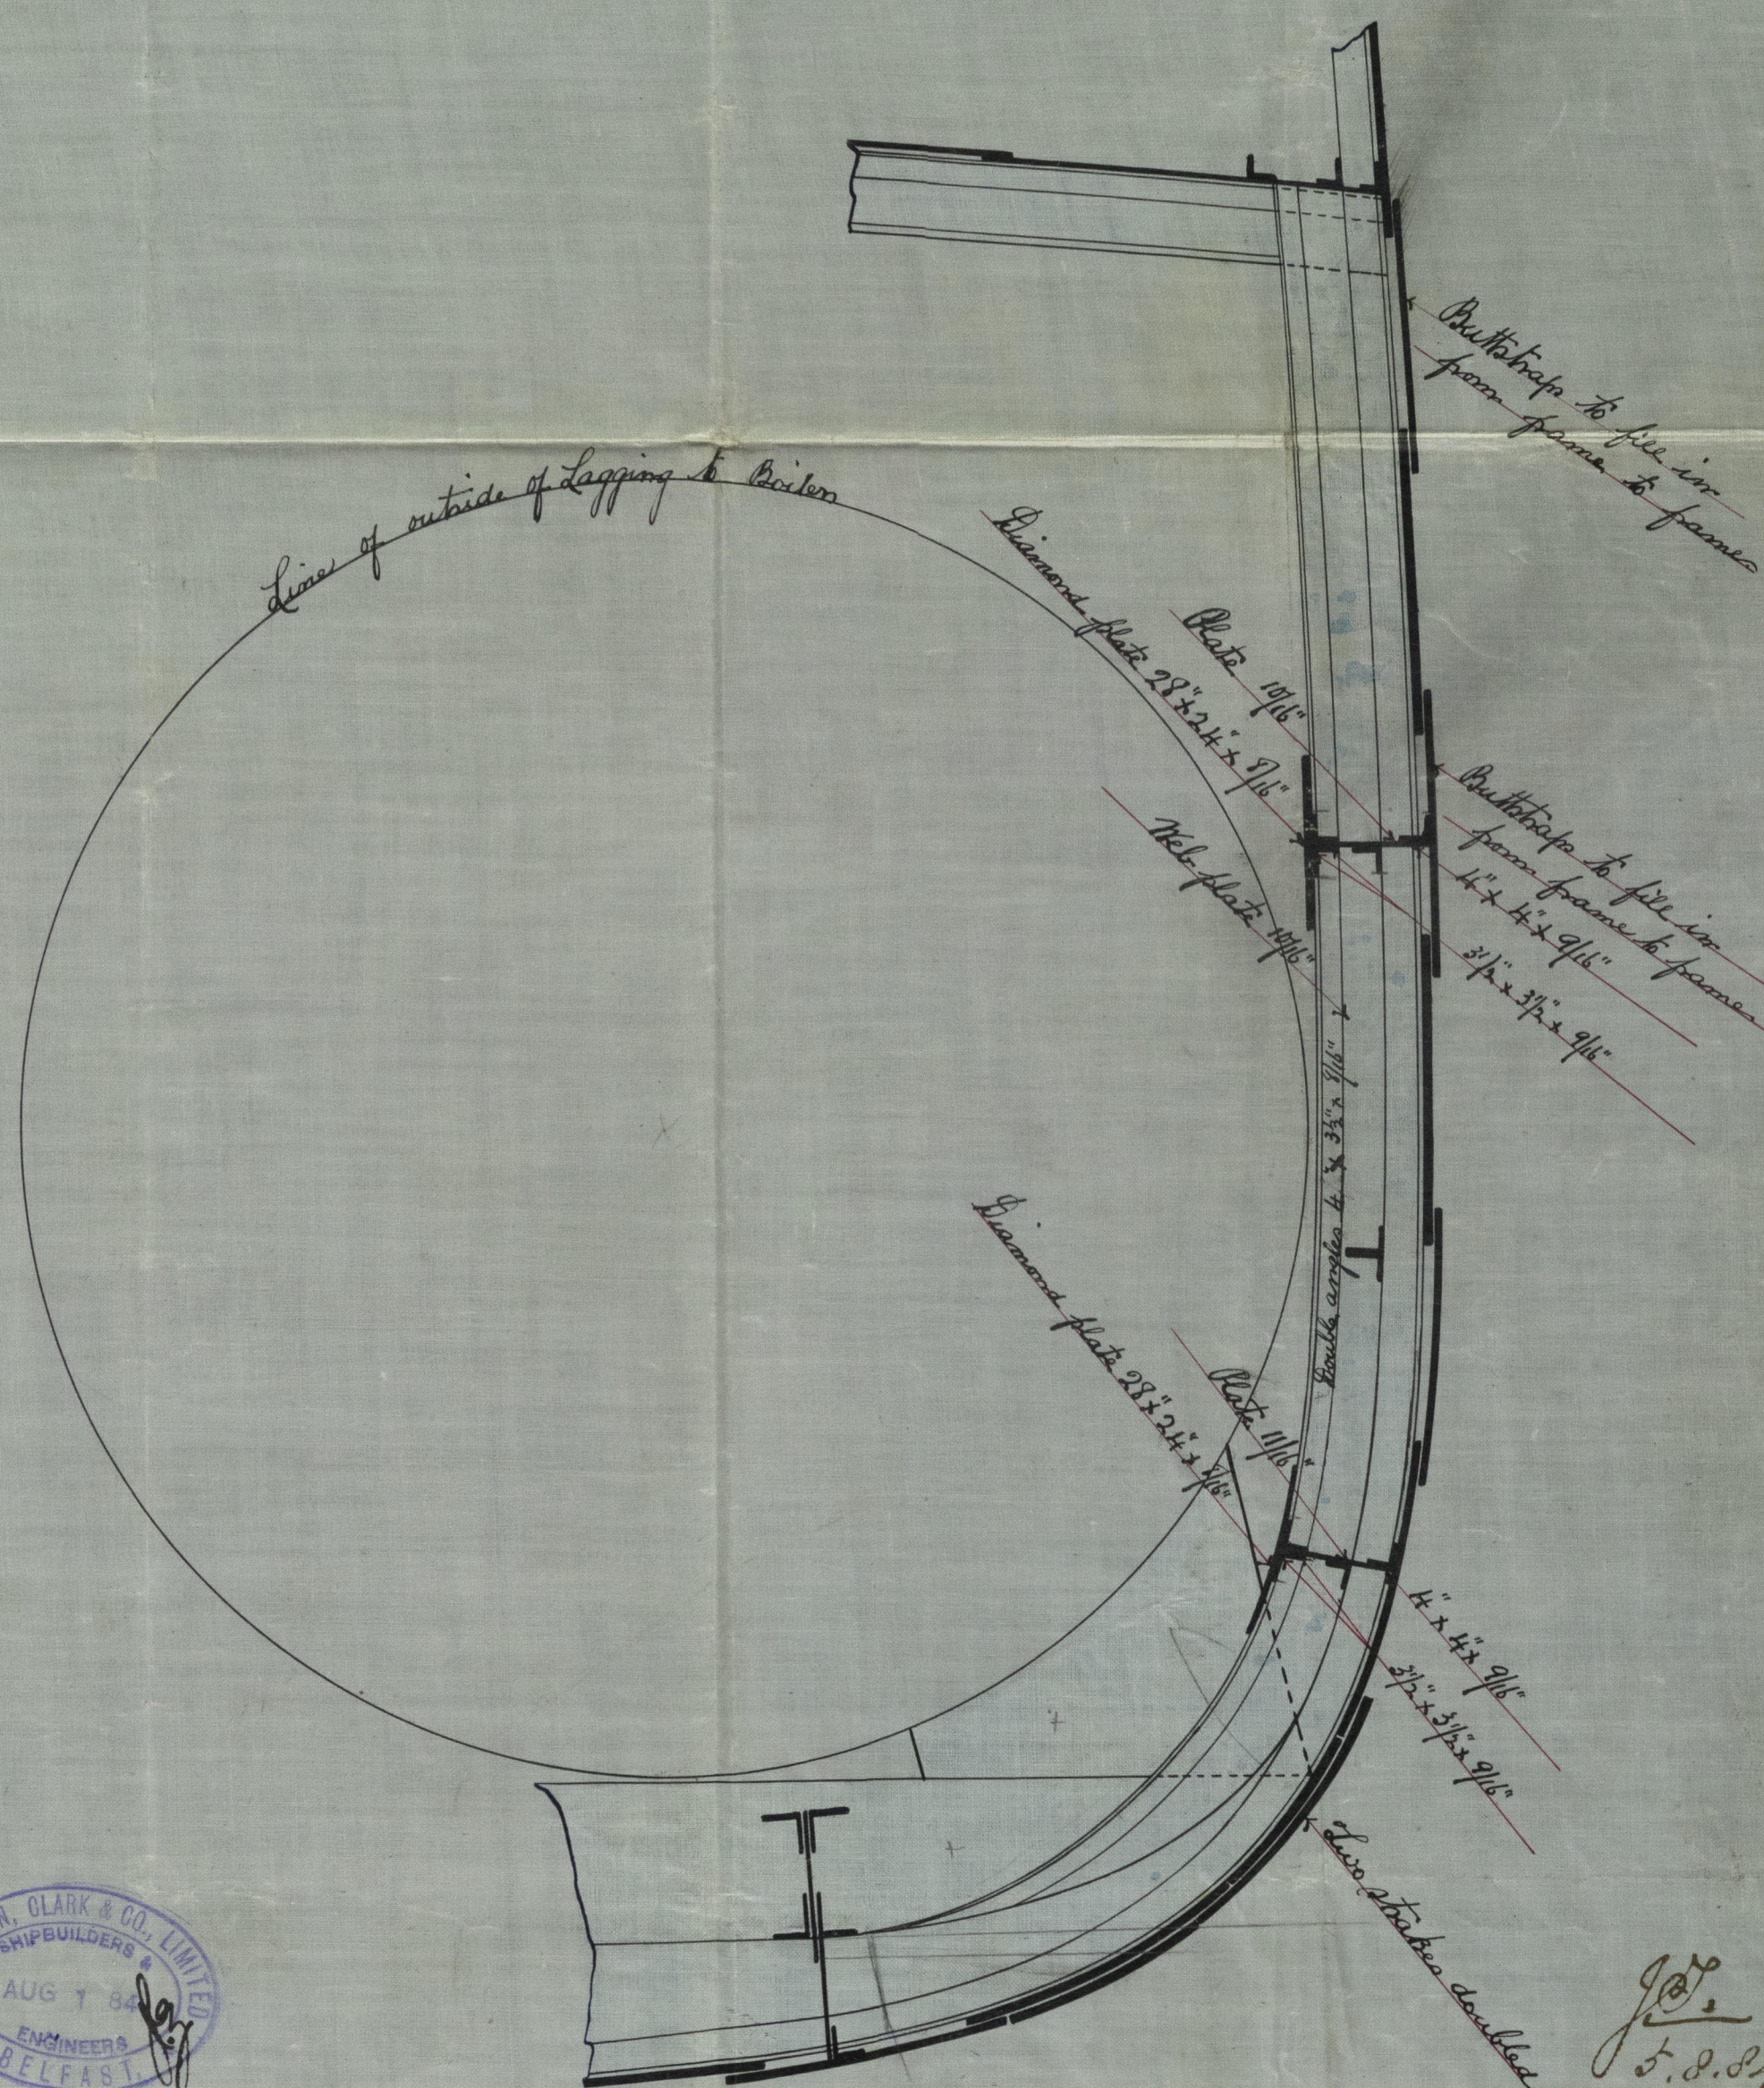

— Scale $\frac{1}{2}$ inch = one foot. —



© 2021 Lloyd's Register Foundation