

No: 30.

Belfast Report No 3173

G. Smith & Son

Half Midship Section of S.S. $40\frac{1}{2} \times 48'$ Extreme $\times 31' 10"$ Keel to Upper deck

— To Class 100 A-1 2 Lloyd's three decked rule —

Half girth	49.95
" Bath.	23.9
Depth to U.D	31.75

Depths in L 12.6 ~~L~~ 16.7
Breadths do. 8.4

First No. $\frac{7.0}{98.6} \times 402.16$ 39652.9 = 2nd No.


— Scale $\frac{1}{2}$ " = one foot. —

2700 to Belfast,
31st March, 1884.

8/8/84.

11/10/84

29.1.85.

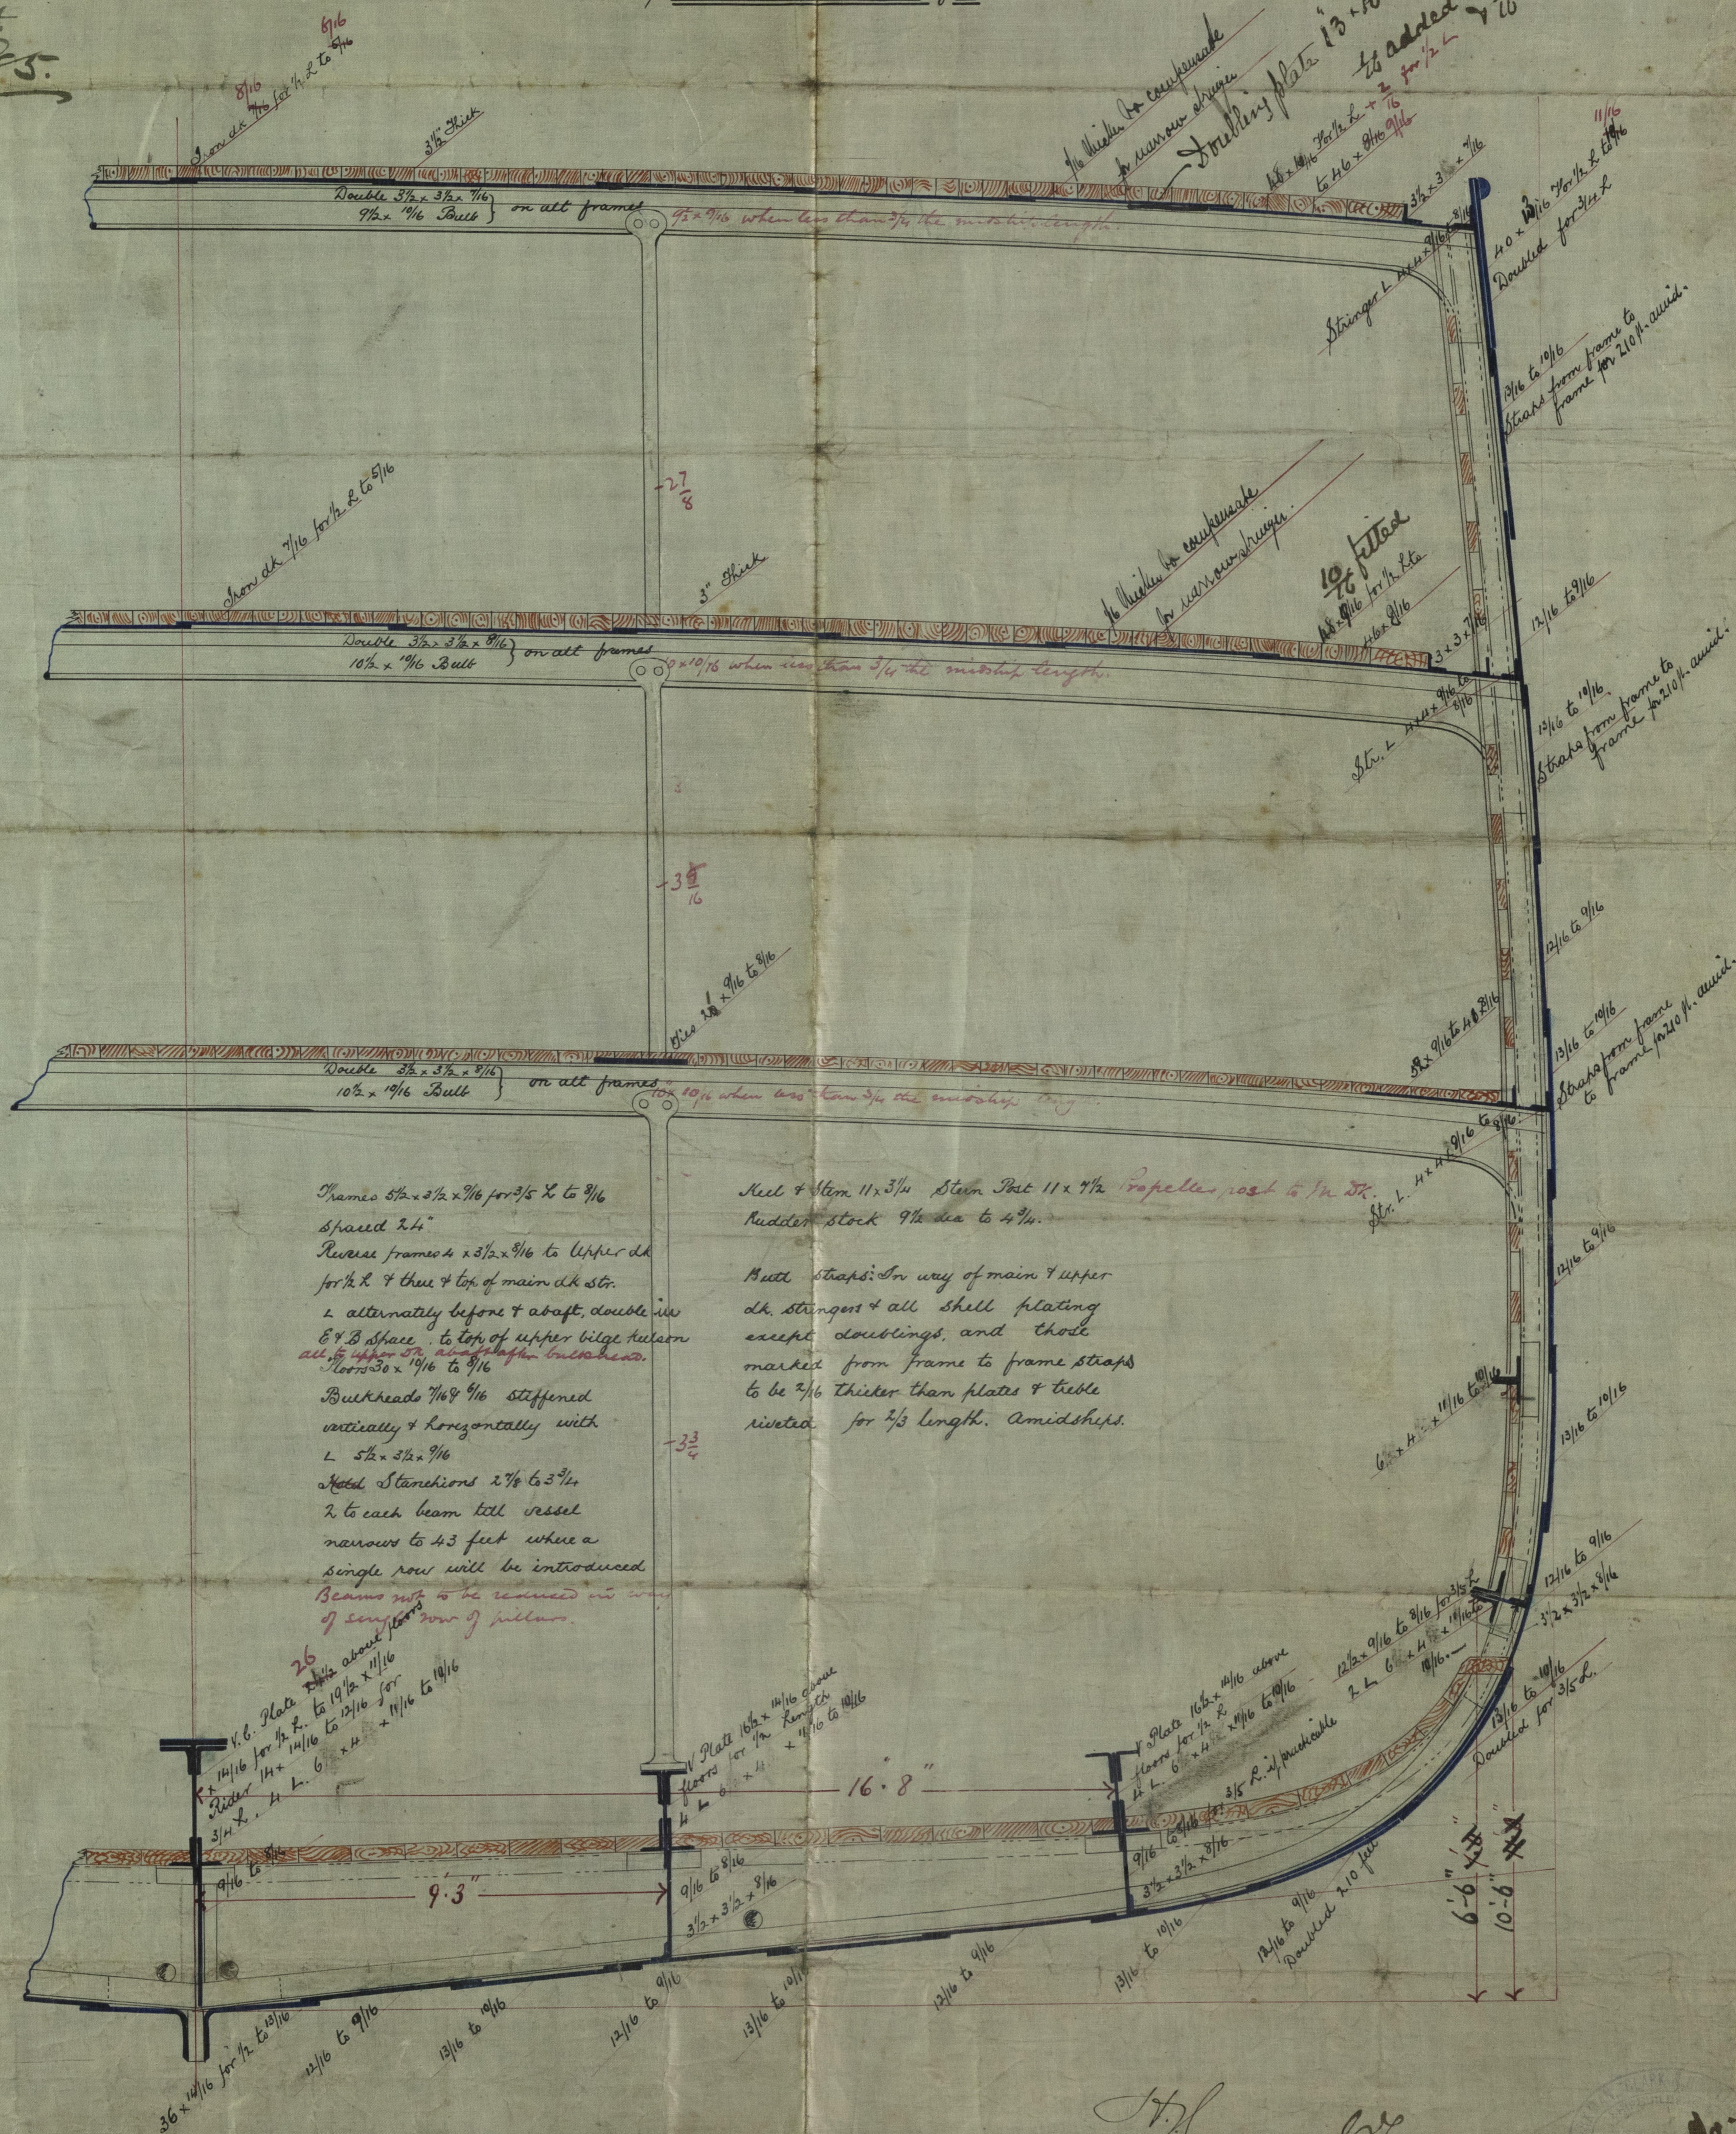

29/3/84

26. 3. 84

© 2021


 Lloyd's Register
 BEL53-0170 Foundation