




— LOWER DECK STRINGER —

— N° 185 —

— Scale 1" = 1 foot —

S.S. "Iran"
Belfast Report
No 3201

24.9.85.

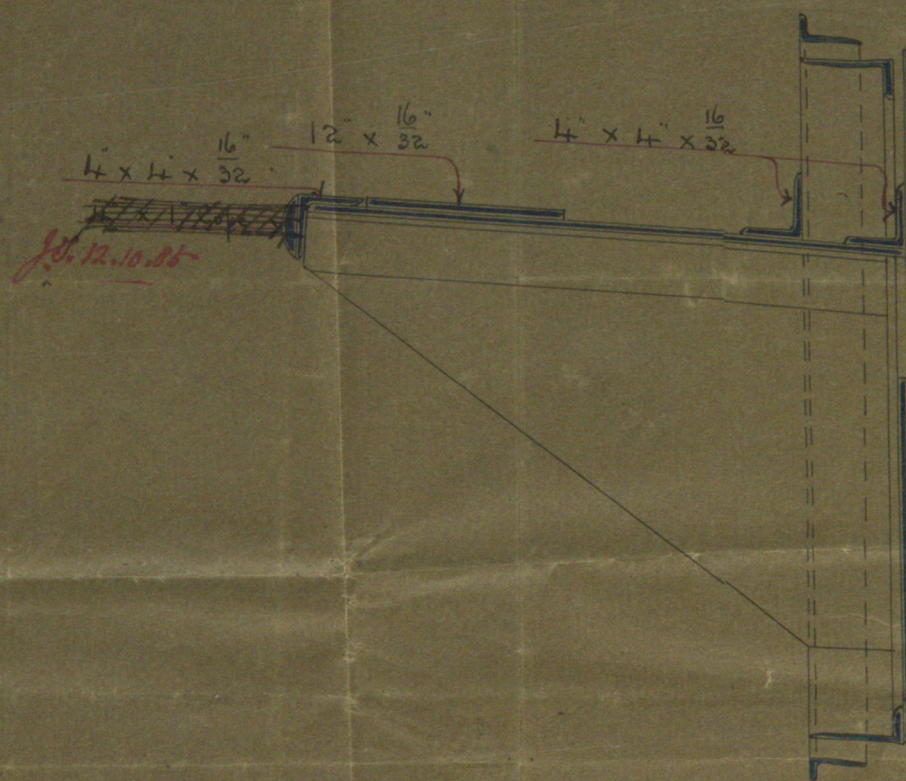

12 Sep
1885
WHL



16.9.85

Lloyd's Register
Foundation
BEL53-0210