


Ltr to Belfast
10/11/85

D. R.
B'no. 9/11/85.

No 185.S.
PUMPING ARRANGEMENT
Scale 1/2"

S.S. "Iran"
Belfast Report,
No 3261

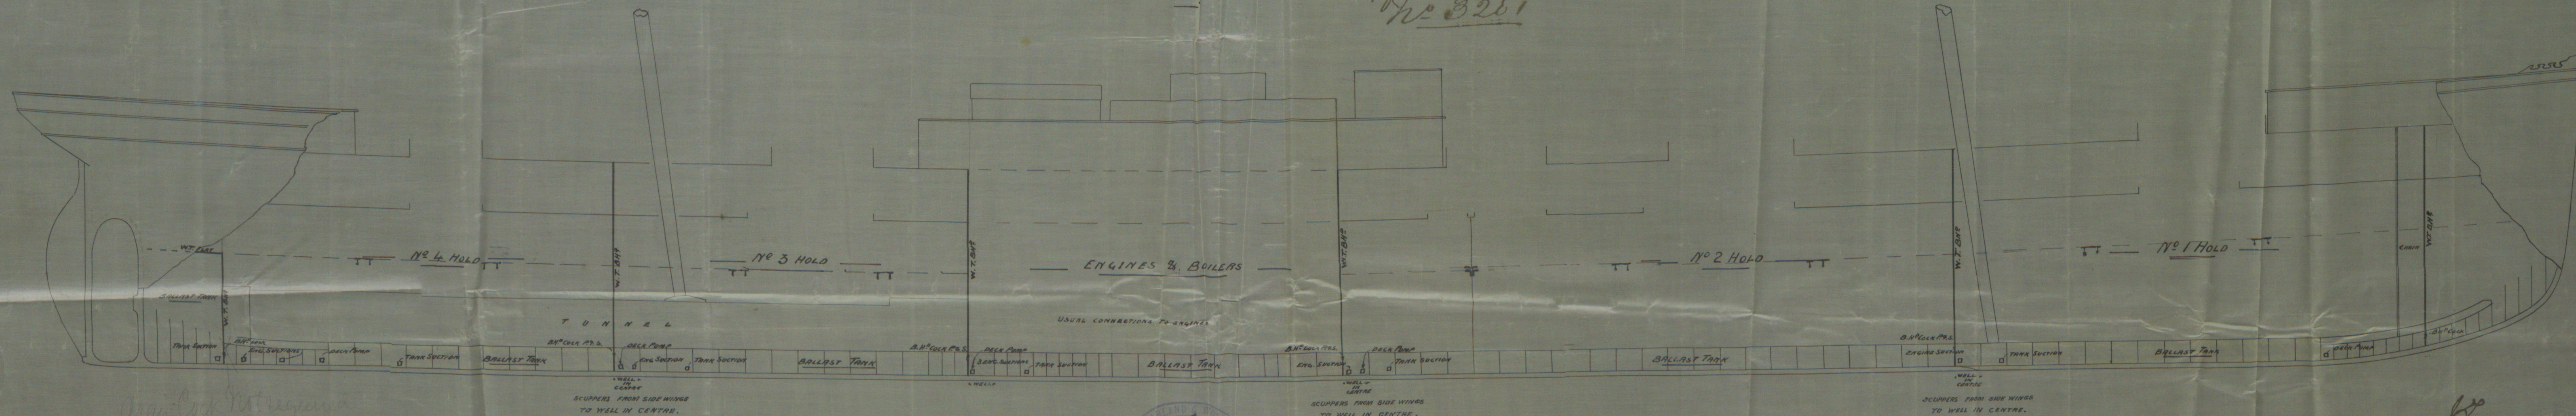

Anchor Cock Not required



D.R.
10/11/85



© 2021
Lloyd's Register
Foundation