
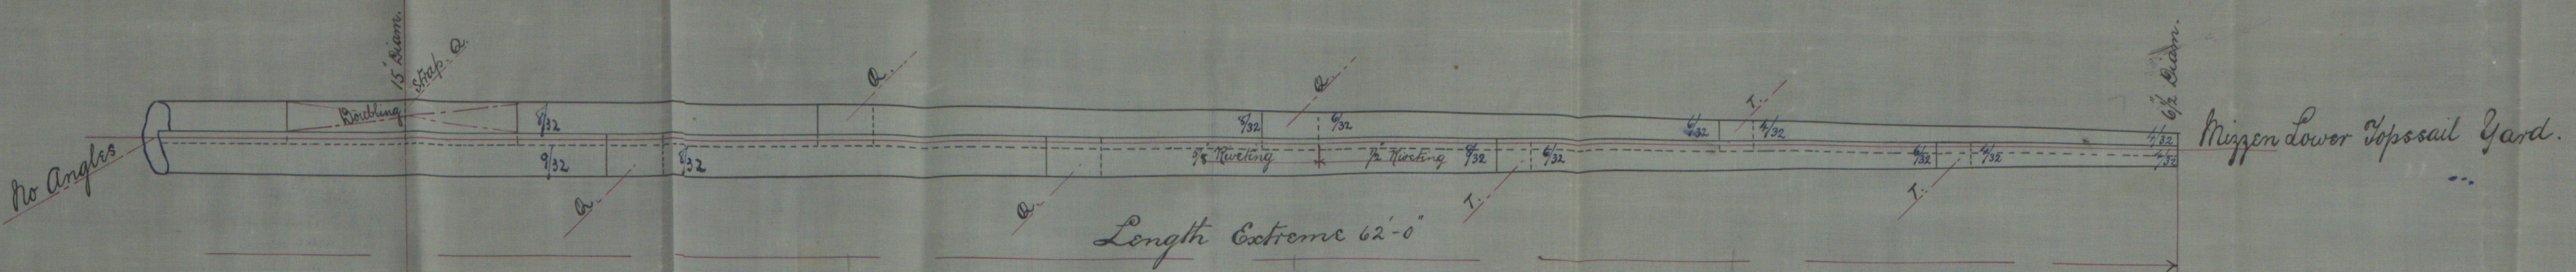
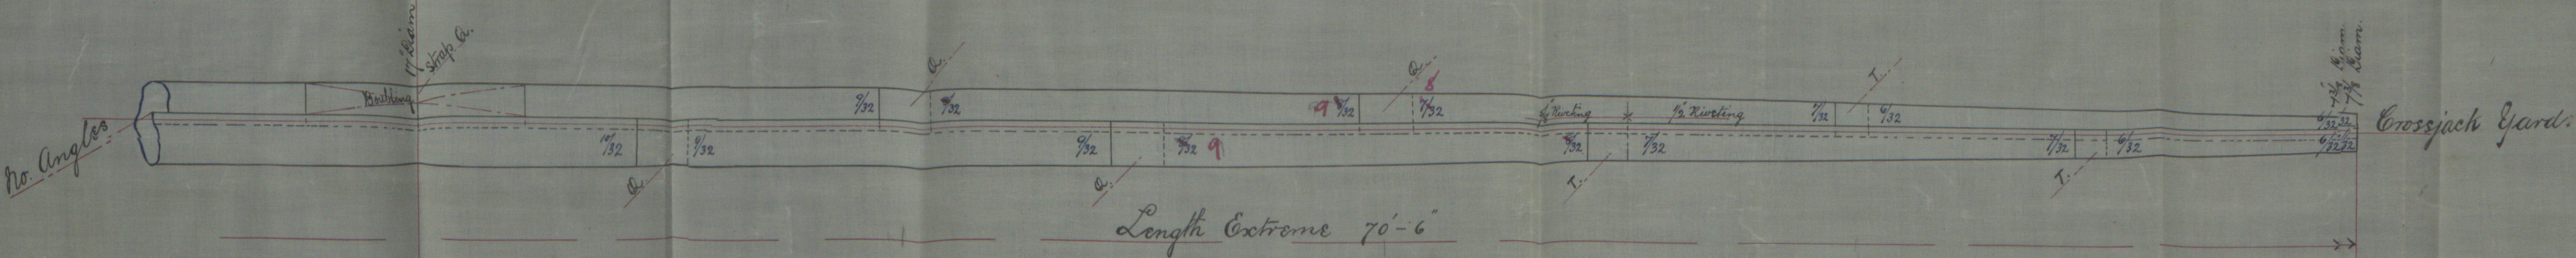
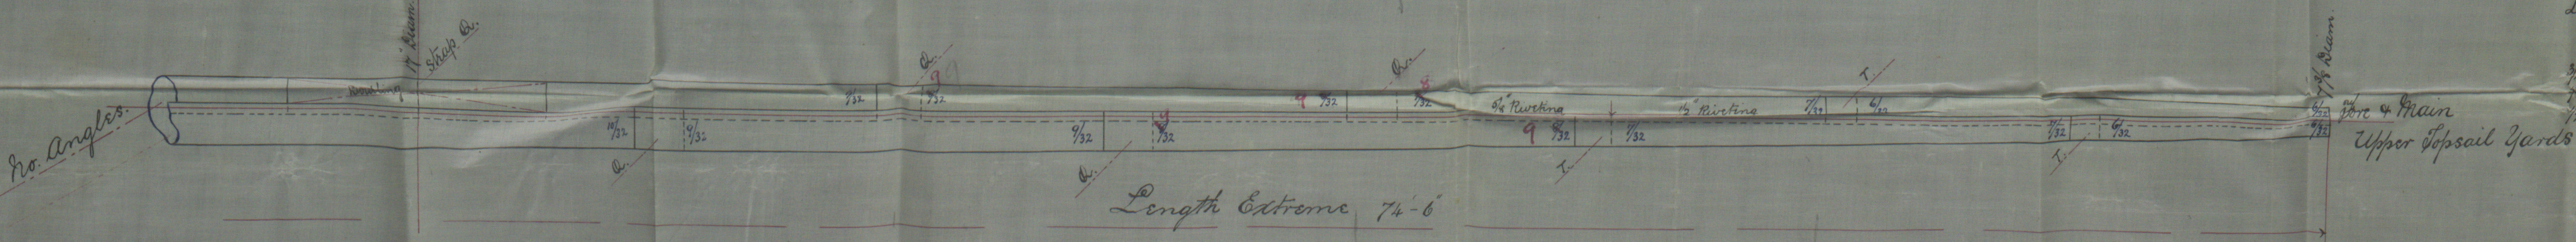
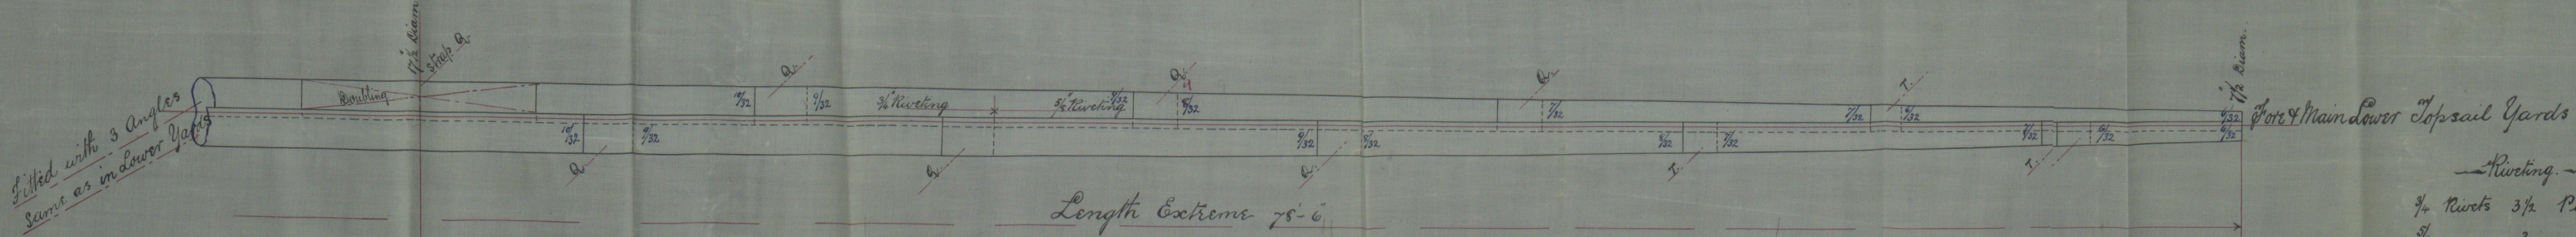



Steel Yards No. 37 Sailing Ship
Scale $\frac{1}{2}$ Inch = One foot.

"Star of Austria"
Belfast Report No. 32205

21.9.85

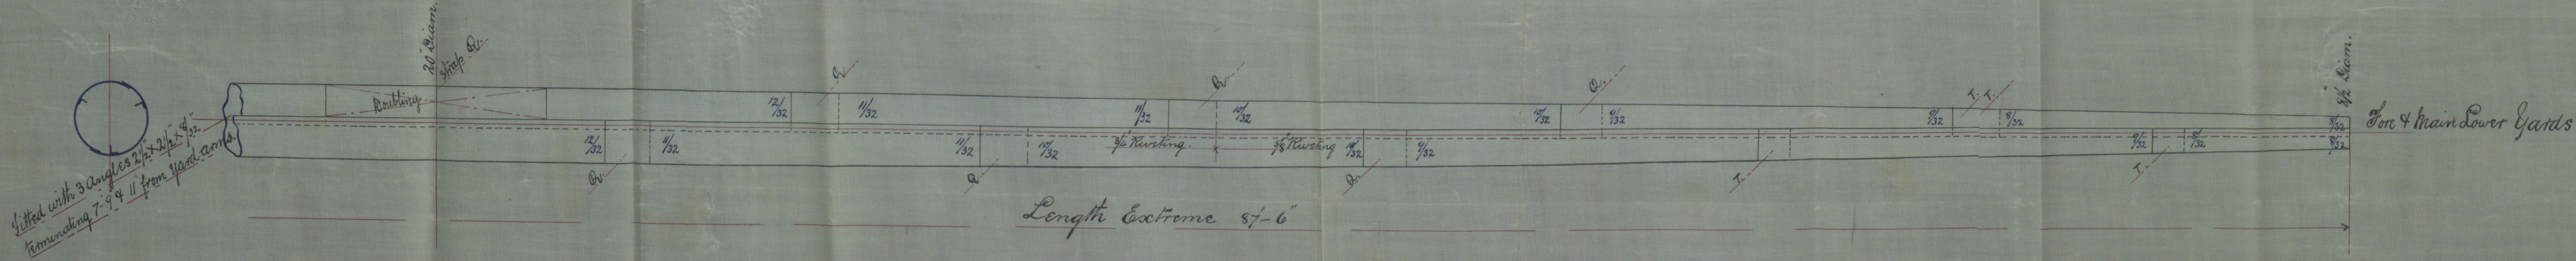

Riveting.
 $\frac{3}{4}$ Rivets $3\frac{1}{2}$ Pitch
 $\frac{1}{2}$ " 3 "
 $\frac{1}{2}$ " $2\frac{1}{2}$ "
Laps marked Q. are Quadruple riveted.
" T. " Treble
 $\frac{3}{4}$ Quadruple Laps $13\frac{1}{2}$ — $\frac{3}{4}$ Treble Laps $9\frac{1}{2}$
 $\frac{1}{2}$ " " $11\frac{1}{2}$ — $\frac{3}{4}$ " " $8\frac{1}{2}$
 $\frac{1}{2}$ " " $9\frac{1}{2}$ — $\frac{1}{2}$ " " 7

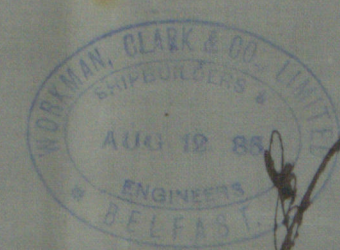

21.9.85