LLOYD'S MARITIME MUSEUM RECEIVED 1985

14.9.85.
21.9.85.

Steel Masts & Bowsprit No. 37 Sailing Ship

Scales: Length ½ inch = One Foot Diam. - 1" = One Foot

"Star of Austria"
Belfast Report No. 3205

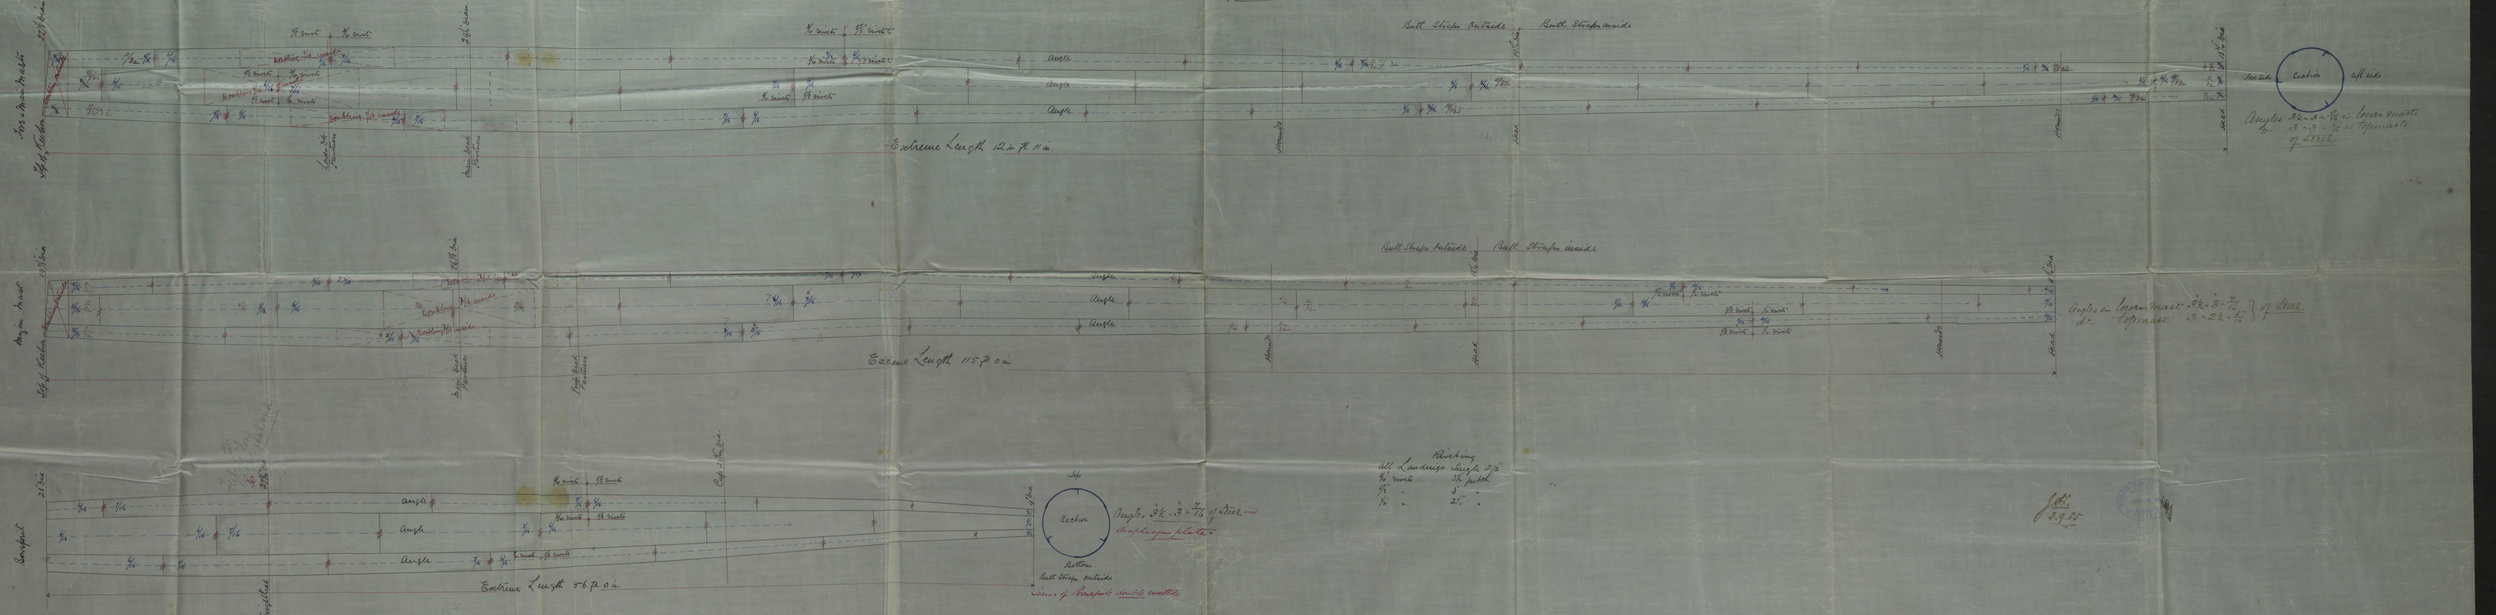

J.S.
3.9.85