


LLOYD'S REGISTER OF SHIPPING  
 RECEIVED  
 23 NOV. 85  
 LONDON  
 LLOYD'S REGISTER OF SHIPPING  
 RECEIVED  
 1 DEC. 85  
 LONDON

28/11/85  
 4/12/85

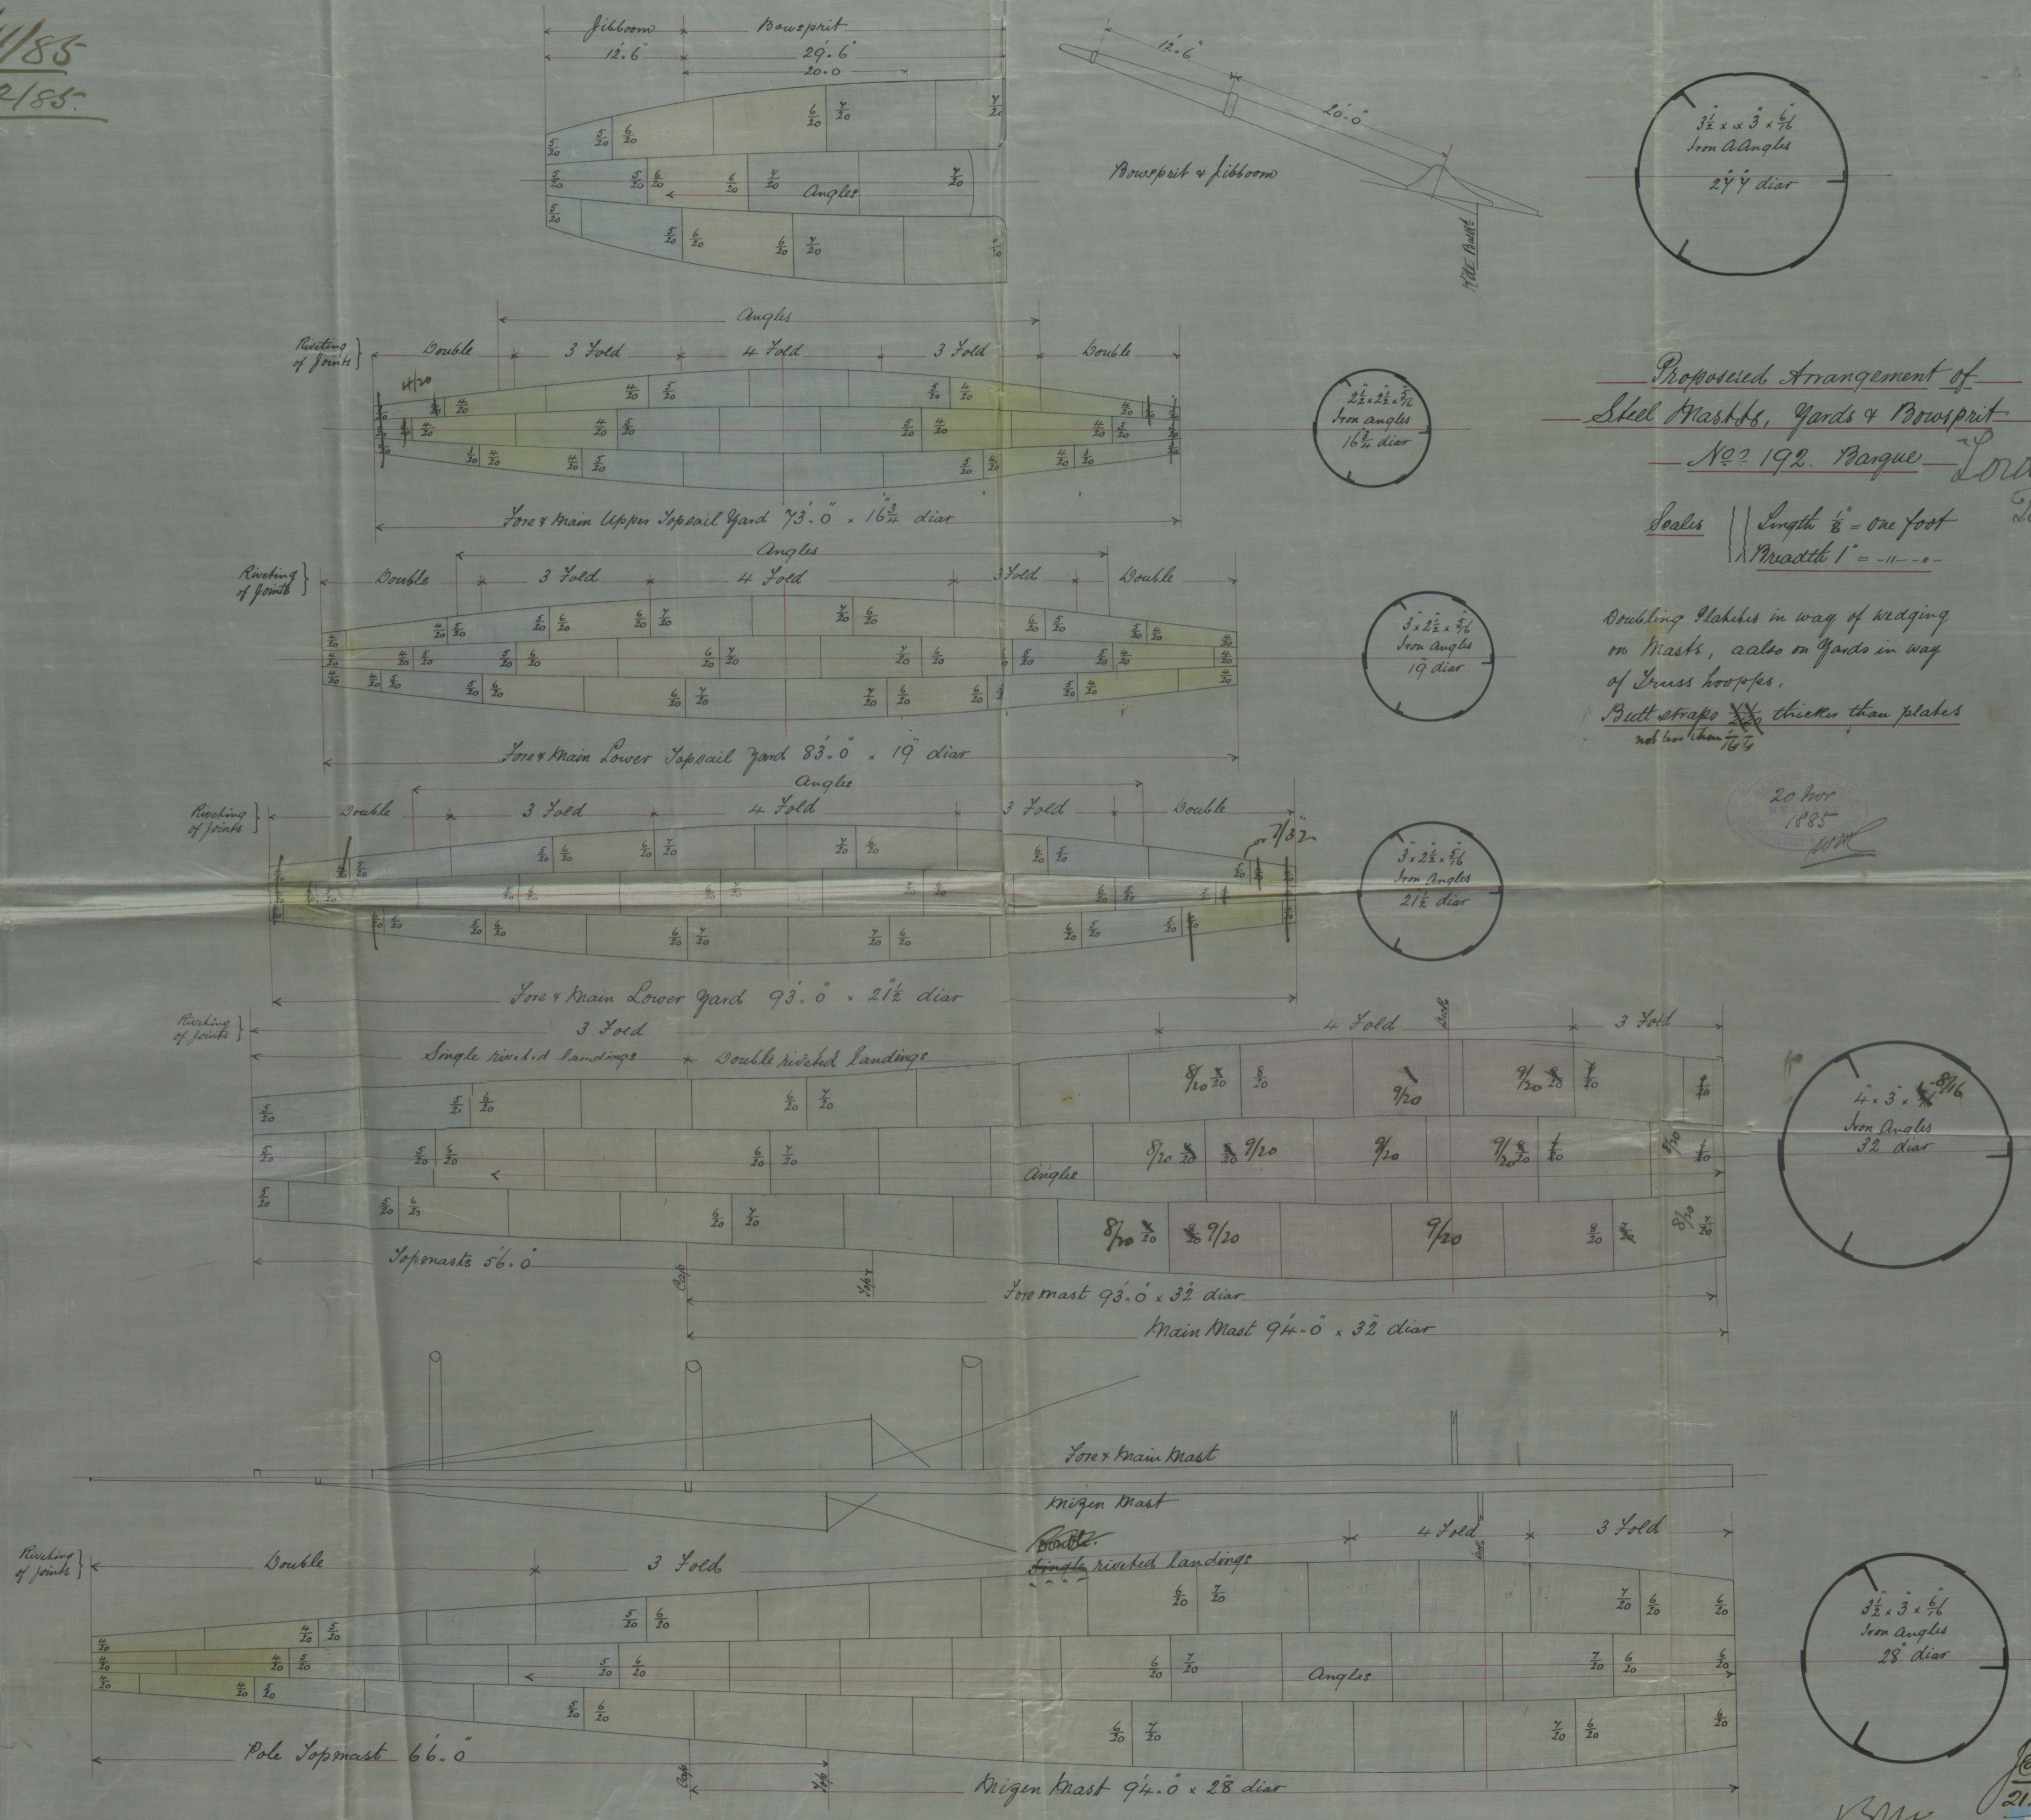

Proposed Arrangement of  
 Steel Masts, Yards & Boomsprit  
 No 192. Barque Lord Templeton  
 Belfast Report  
 No 3222

Scales || Length 1" = one foot  
 Breadth 1" = 11"

Doubling plates in way of wedging  
 on masts, also on yards in way  
 of cross hoops.  
 Butt straps ~~not~~ thicker than plates  
 not less than 1/4"

20 Nov  
 1885  
 J. W.

28/11/85