

The words FORGINGS or CASTINGS, IRON or STEEL, should be struck out as may be required.

Received at

Office,

18

Lloyd's Register of British and Foreign Shipping.

(Report on Vessel No. _____ Port _____).

No. 1124

SHIP FORGINGS OR CASTINGS.

I have to report that the undermentioned Iron ~~or Steel~~ Forgings ~~or Castings~~, manufactured by
The Harbour Forge Co of *Irvine*.
for the Vessel No. *192*, being built by *Messrs Harland & Wolff*.
of *Belfast* have been inspected by me as set forth below, and found
to be, so far as can be seen, *sound and efficient*.

Mark on Forgings.

Lloyd's

No. 1124


G. N.

George Newcomb
Glasgow

30/1/86.

	STERN FRAME.	RUDDER FRAME.	STEM.
Material* - - -		<i>Scrap iron</i>	
How made - - -		<i>Forged</i>	
Dimensions - - -		<i>6 3/4 and 3 1/2</i>	
Progress on Inspection -		<i>Forging & smithing</i>	
Dates when Inspected		<i>2.11.16.20.27/11/85. 18.23/12/85. 13.19/1/86.</i>	

SKETCHES OF FRAMES SHEWING POSITION AND DESCRIPTION OF WELDS OF FORGINGS, OR PARTICULARS OF TESTS APPLIED TO CASTINGS.

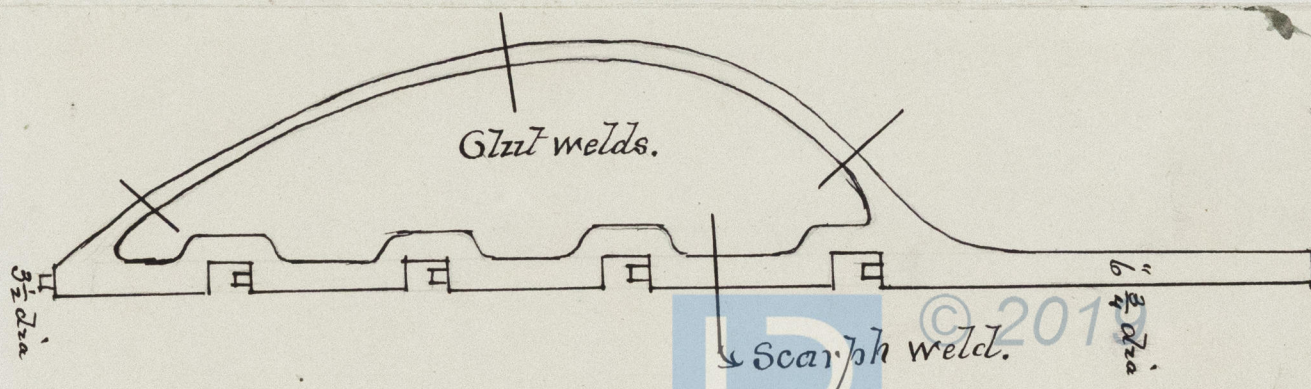

No: 193
Ships Forgings Rudder
Irvine Jan. 130th / 86

London & Templetown
Belfast Reports
No: 3222



© 2019

Lloyd's Register
Foundation