


No 40 'Elgiva' Belfast Report No 3237

Pumping Arrangement Nos 40 & 42 S. S.

Scale 1/8 inch = one foot

M 5/5/86

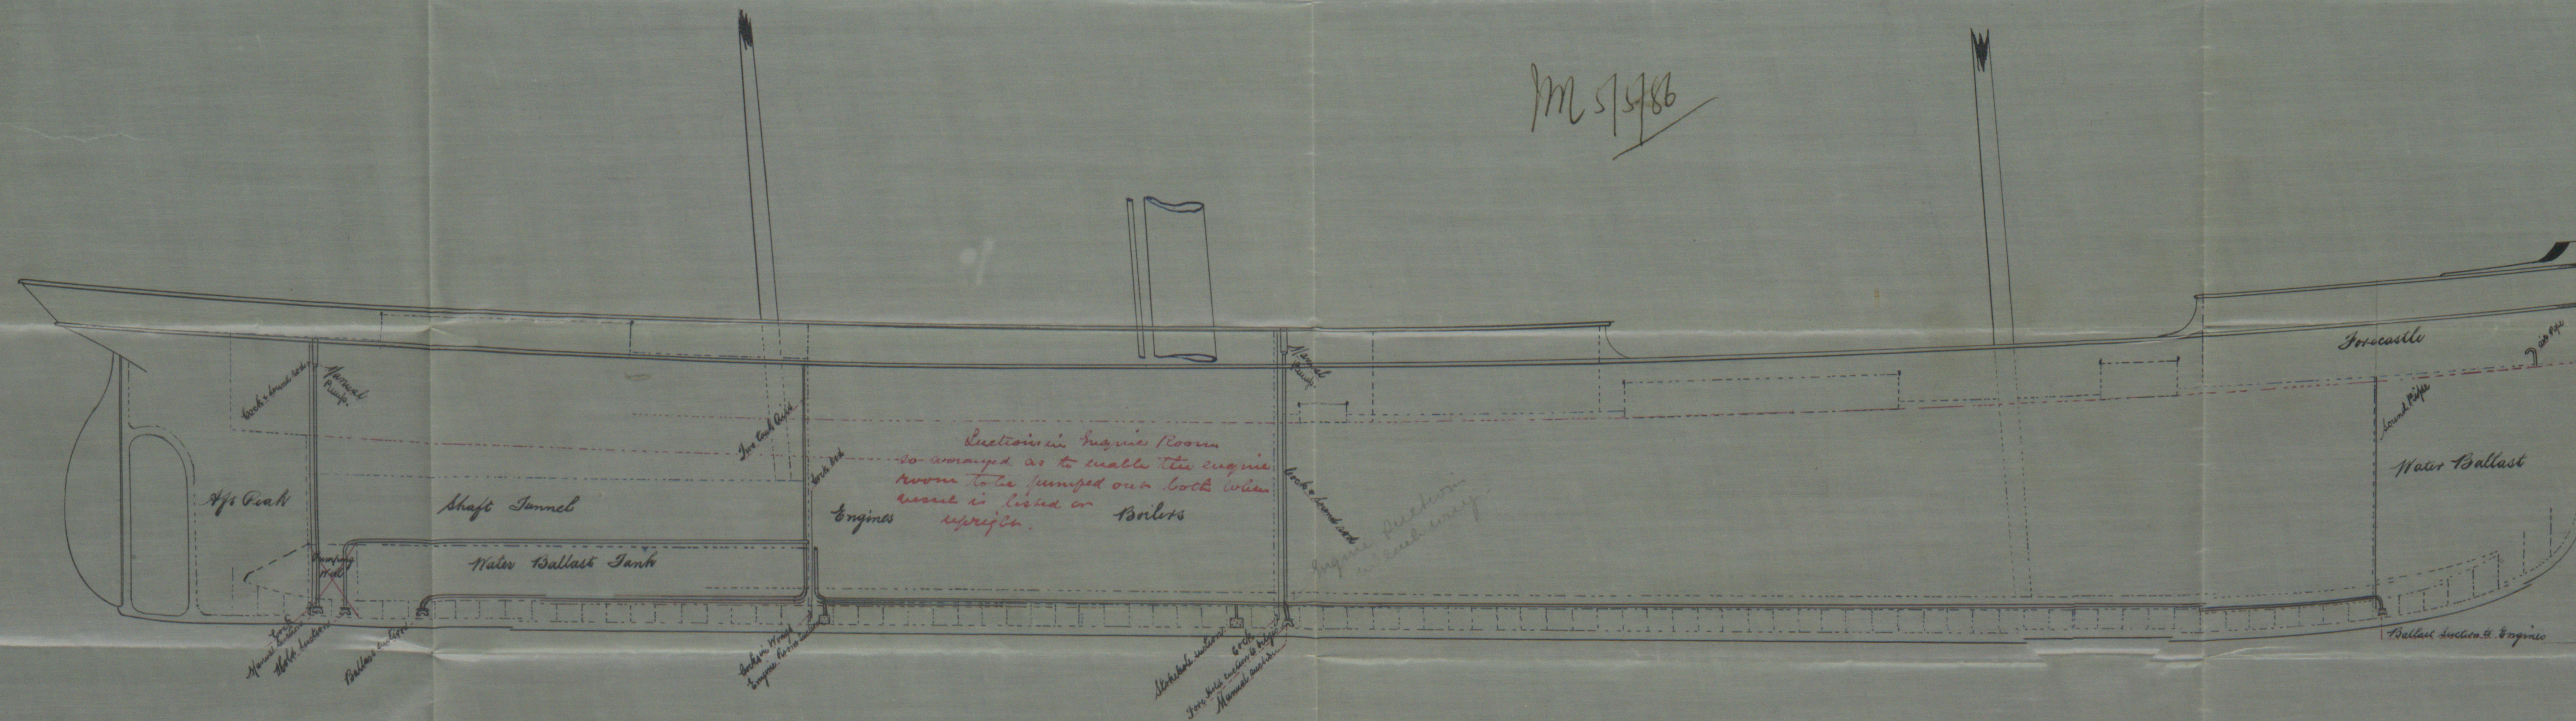

WORTHINGTON, CLARK & CO. LIMITED  
MAY 7 1886

LR

Lloyd's Register  
Foundation