


23/12/85  
5.7.86.

Deep Transom plate.

Longitudinal Section of 8<sup>th</sup> 40x42 S. Sec  
To class no A1  
Scale 1/8 inch = one foot

No 40 'Elgiva' Belfast Report No 8237

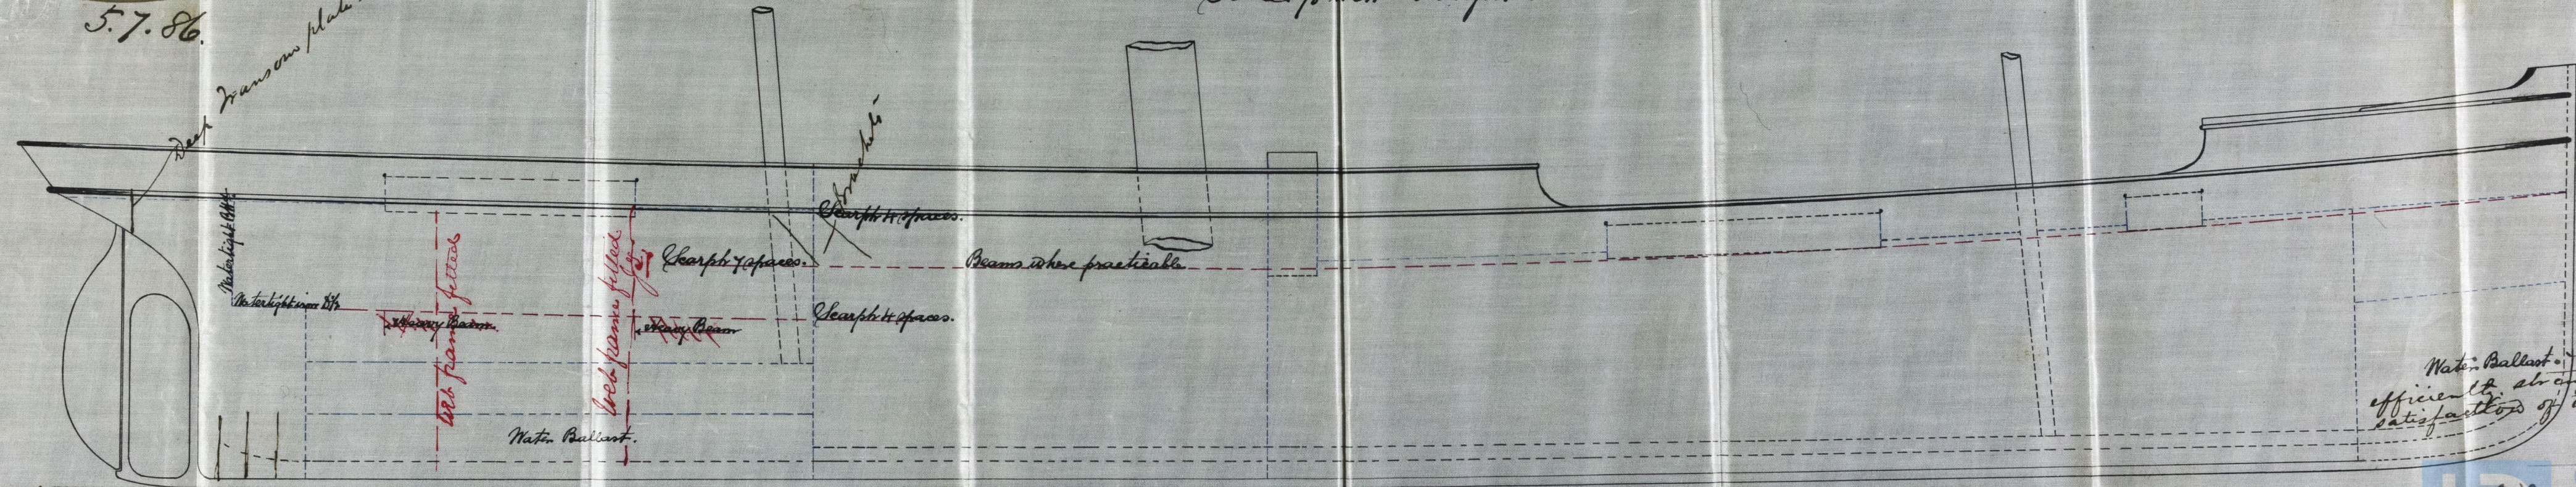

Water Ballast. Tank to be  
efficiently strengthened to the  
satisfaction of the Surveyor

L.H. T.  
23/12/85



© 2019

Lloyd's Register  
Foundation