



2/6/86

Sketch of Stern & Rudder Frames N^o 40 & 42 S.S.


Shewing Arrangement of Pintles.

N^o 40 "Elgiva"

Belfast Report No 3237



Scale $\frac{1}{4}$ inch = one foot

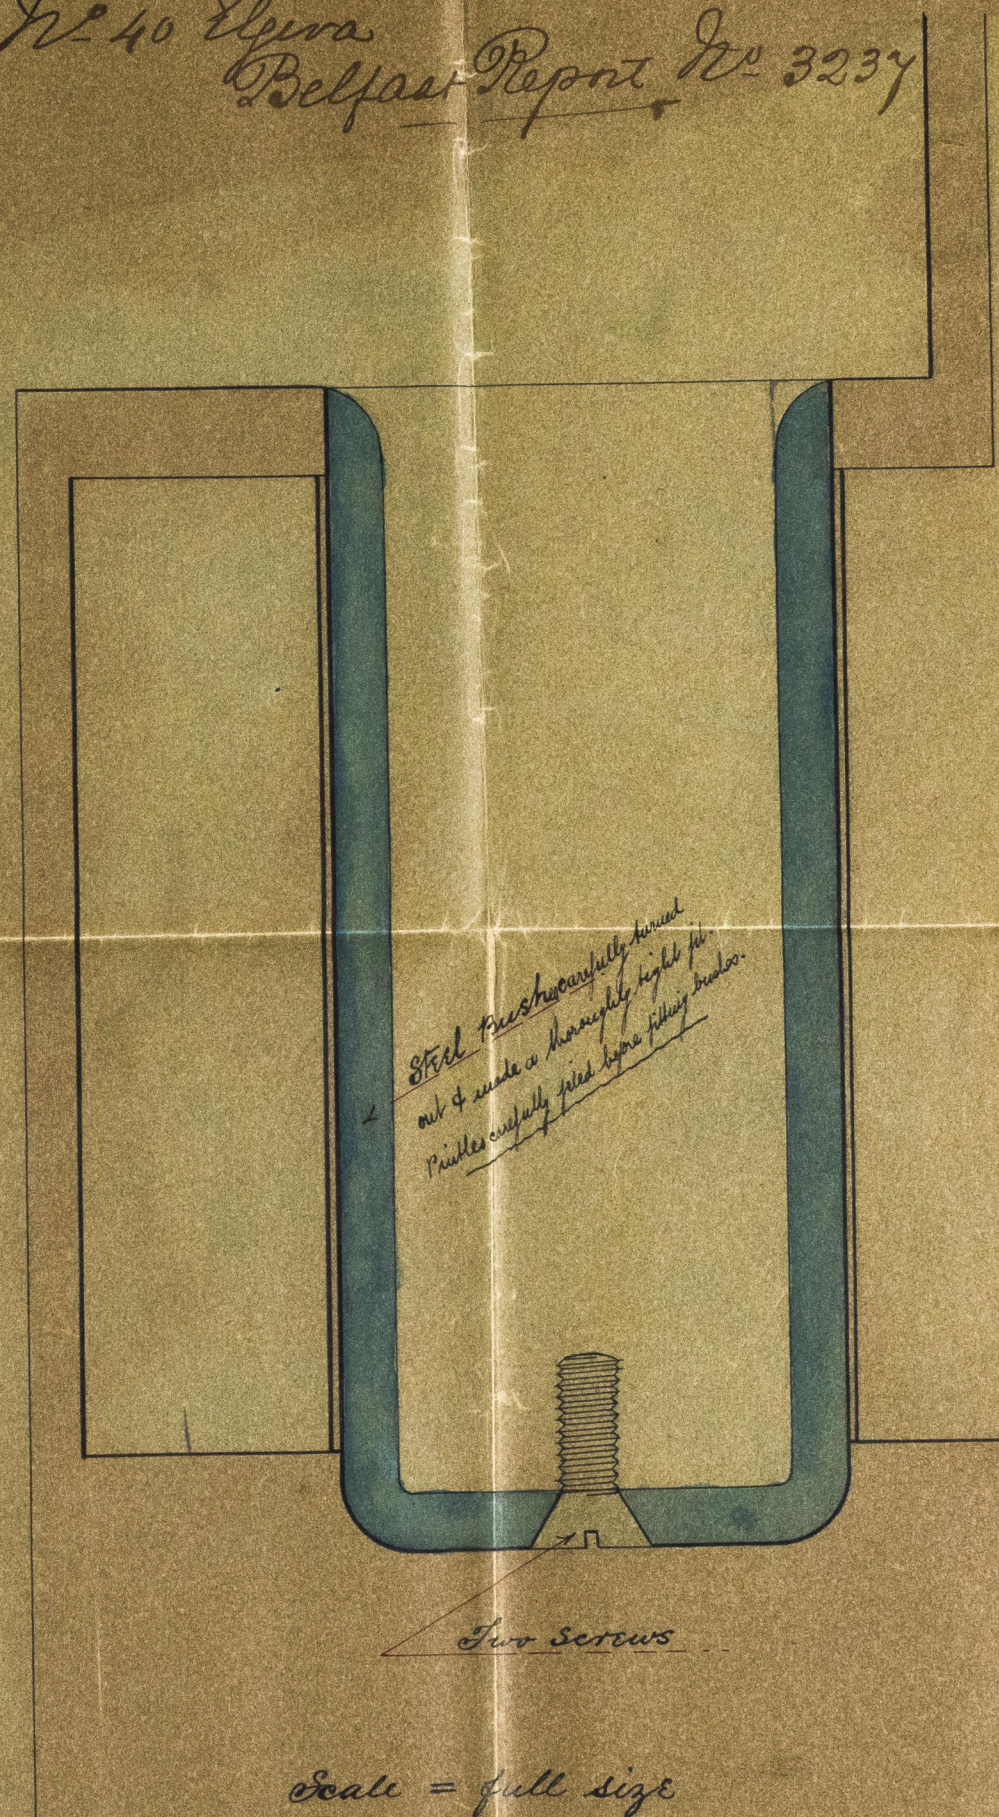

Scale = full size



28.5.86



2/6/86



Lloyd's Register Foundation
3EL53-0282