


RECEIVED
LONDON
6/5/86

6/5/86

Pumping Arrangement N^o 43 S.S. — Broughshane
Scale 1/8 inch = one foot — Belfast Report N^o 3242

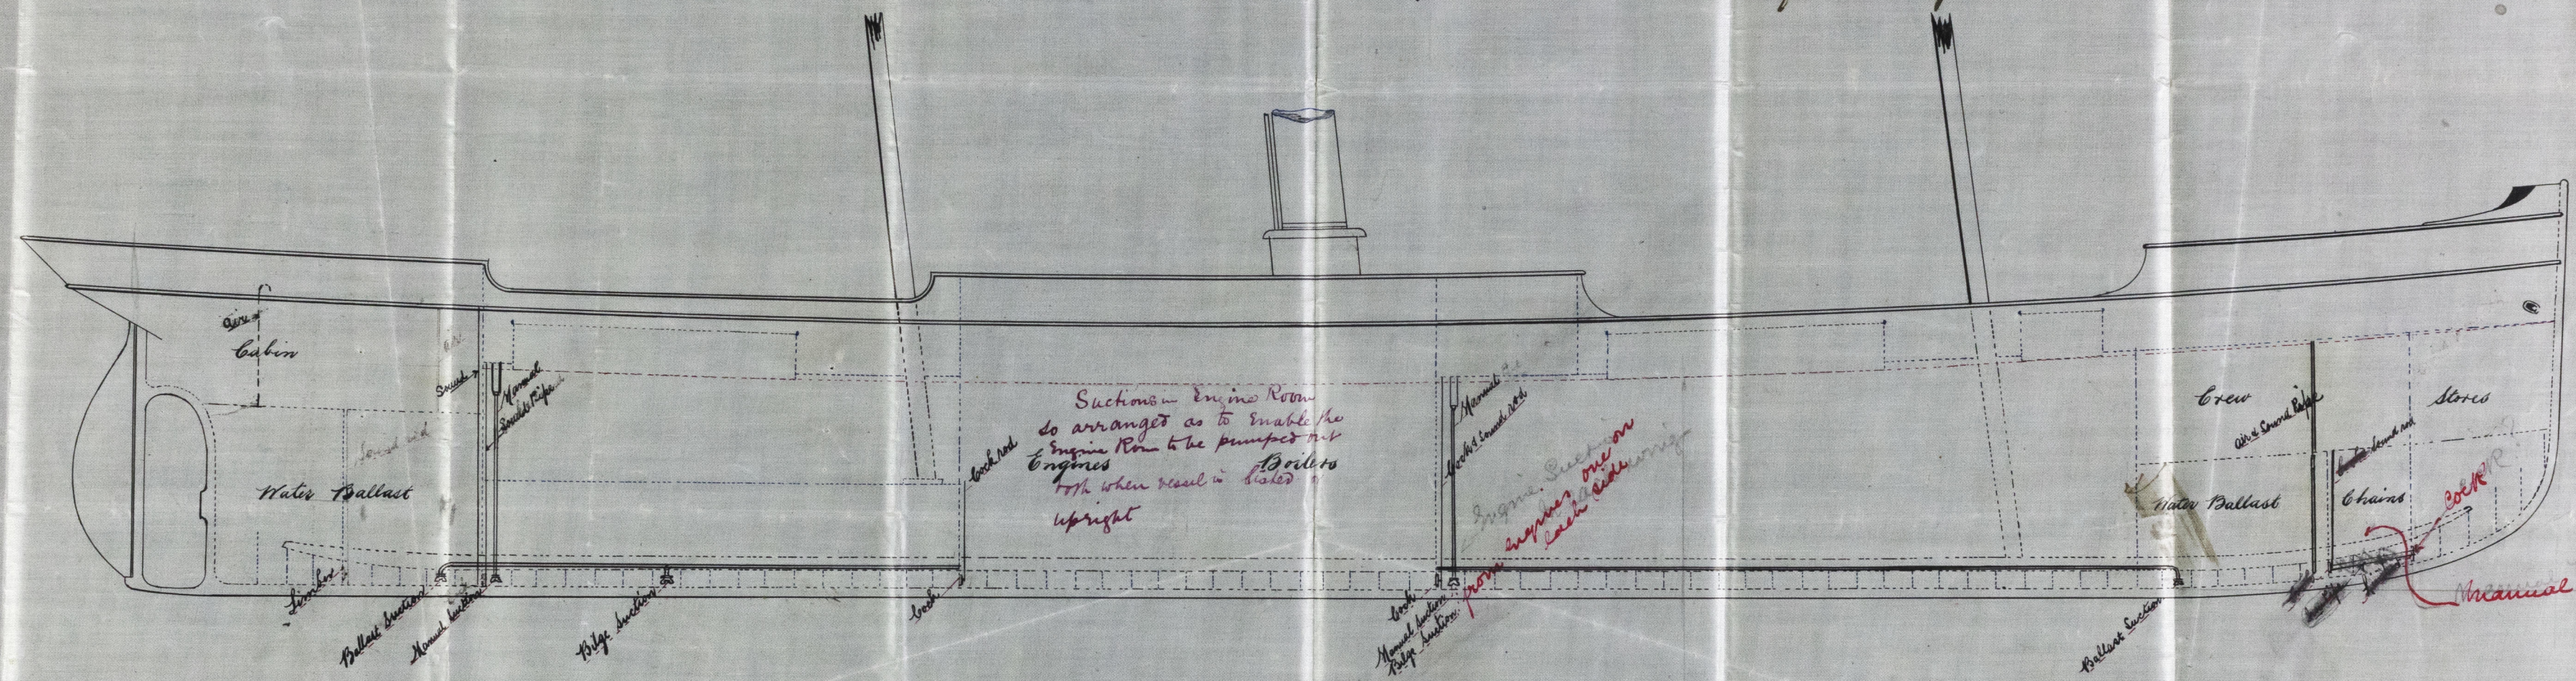

mm 5/5/86

mm 5/5/86

RECEIVED
LONDON
6/5/86