

REGISTERED
FEB 18
LONDON

17.2.86.




JOHN & JAMES THOMSON,
FINNIESTON ENGINE WORKS,
GLASGOW.

N^o 119

JOHN & JAMES THOMSON,
FINNIESTON ENGINE WORKS,
GLASGOW.

Scale 1" = 1 Foot
Pressure 90 lbs

S.S. "Broughshane"
Belfast Report 3242

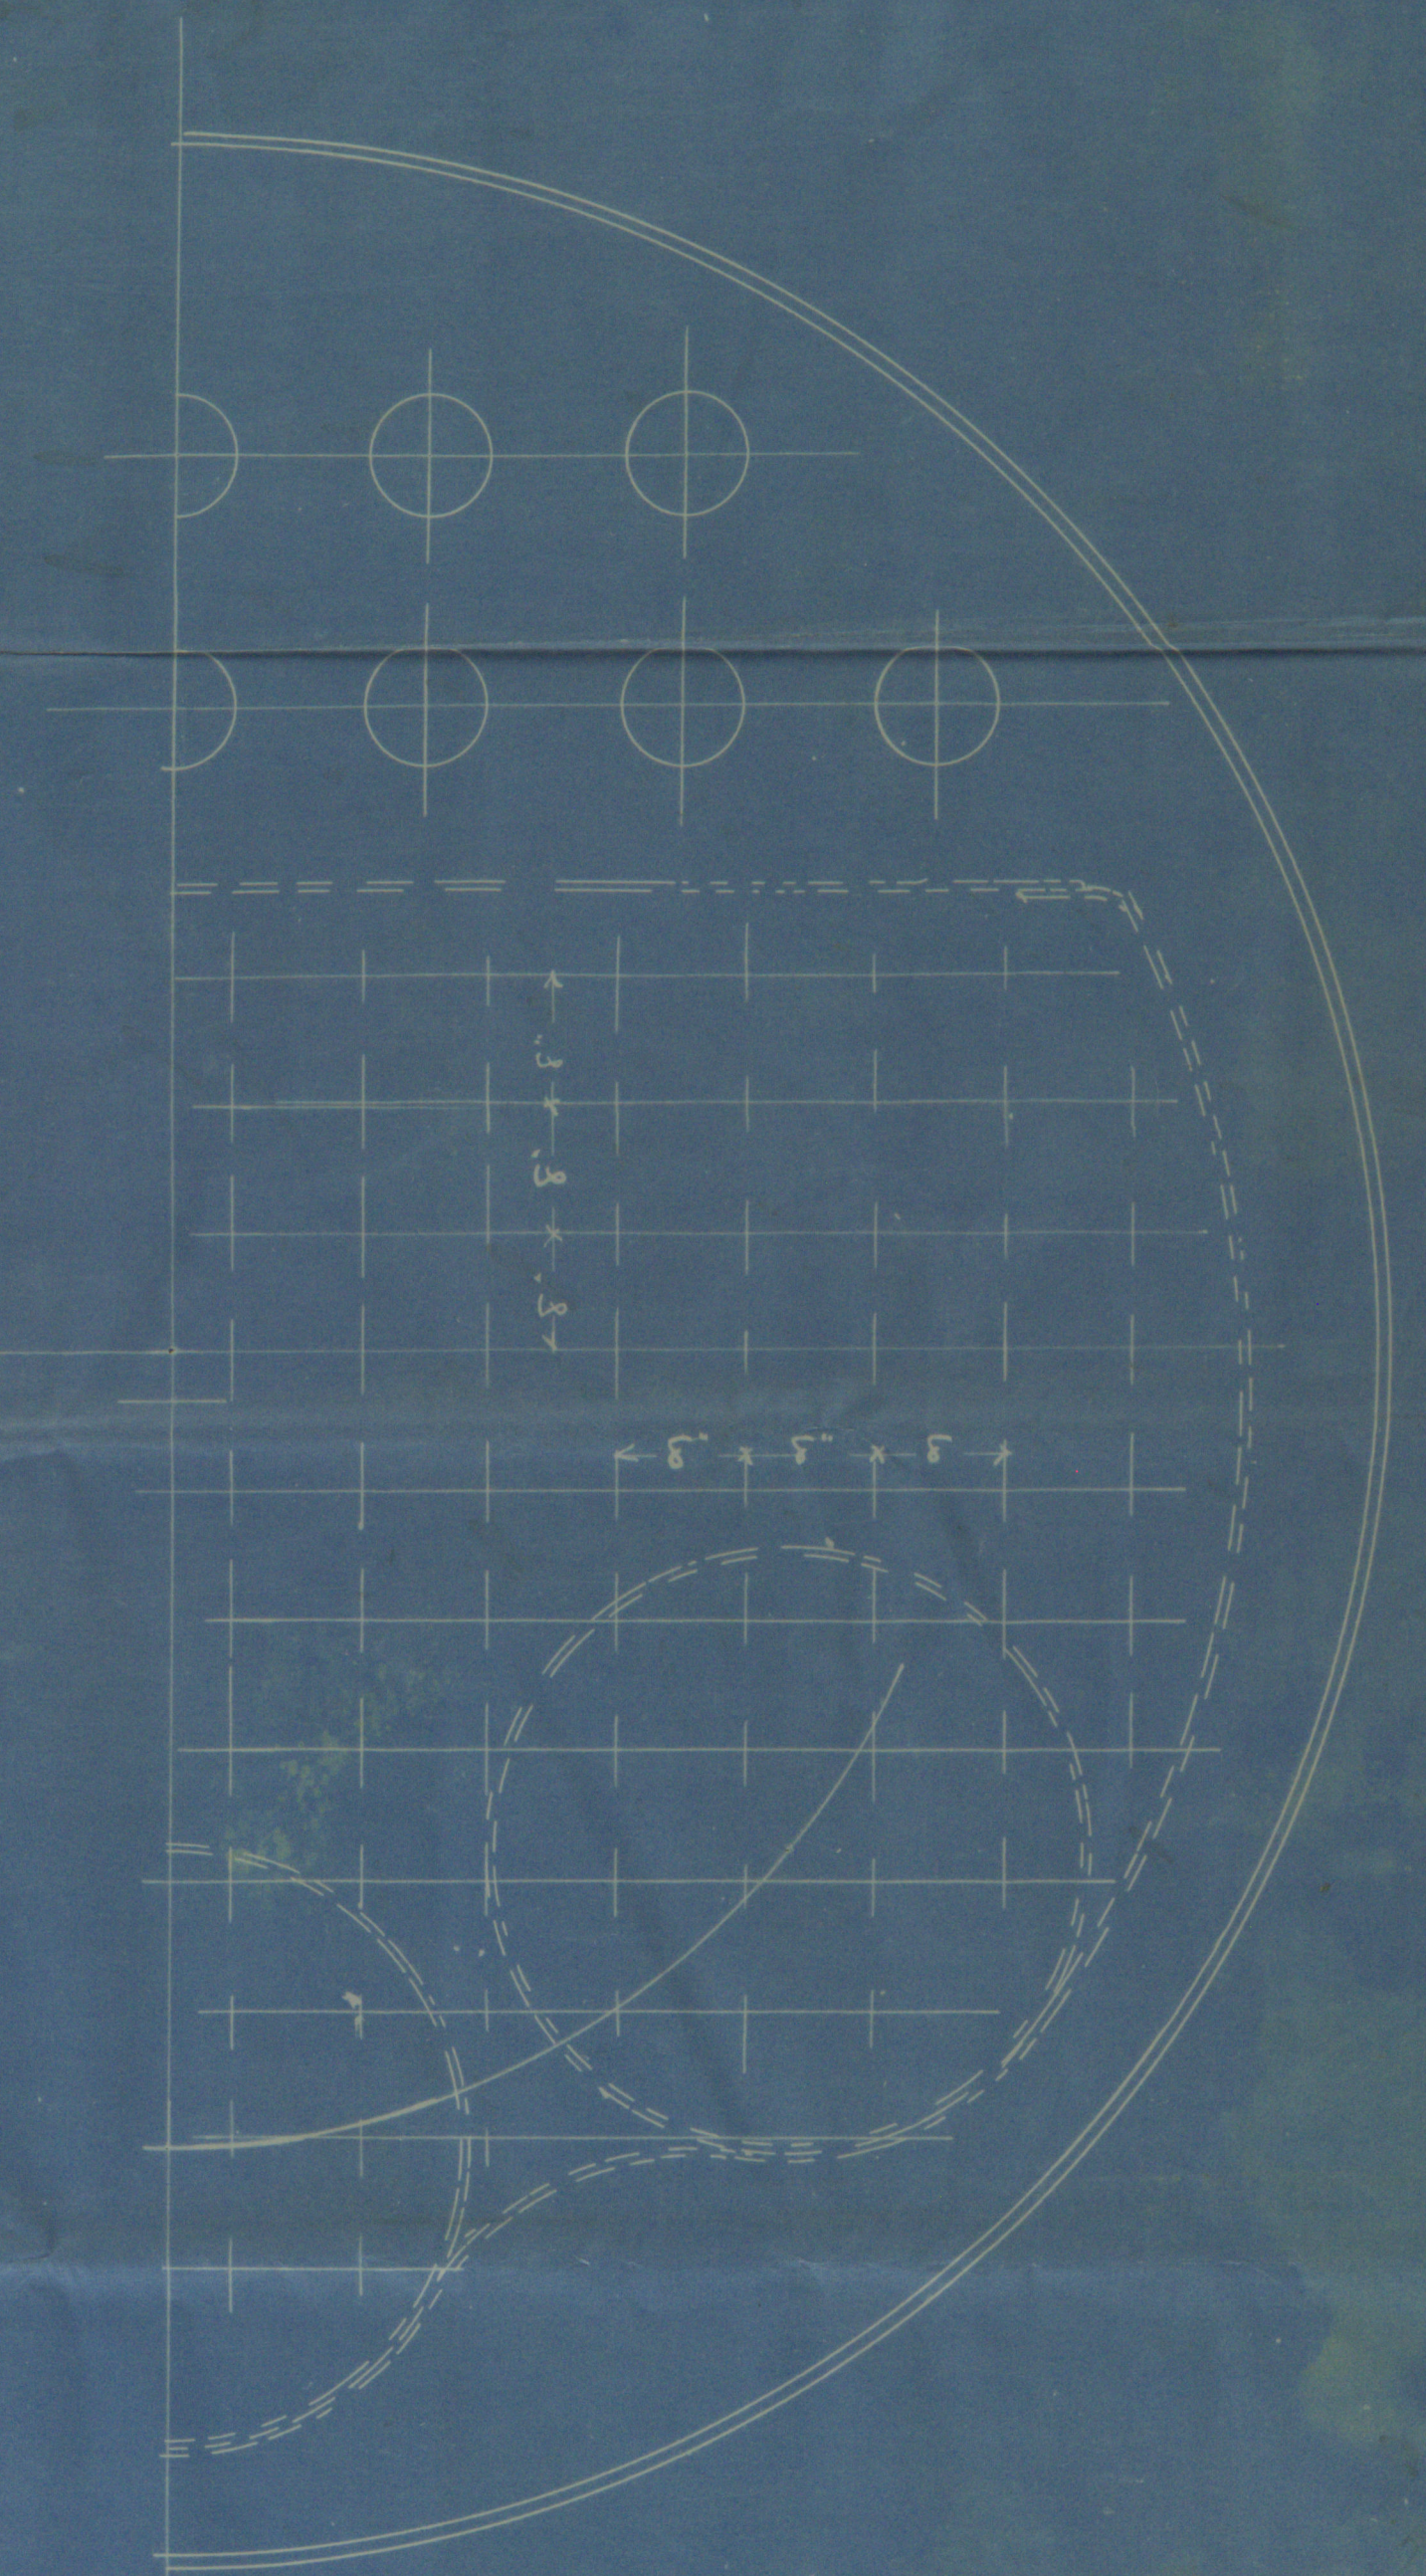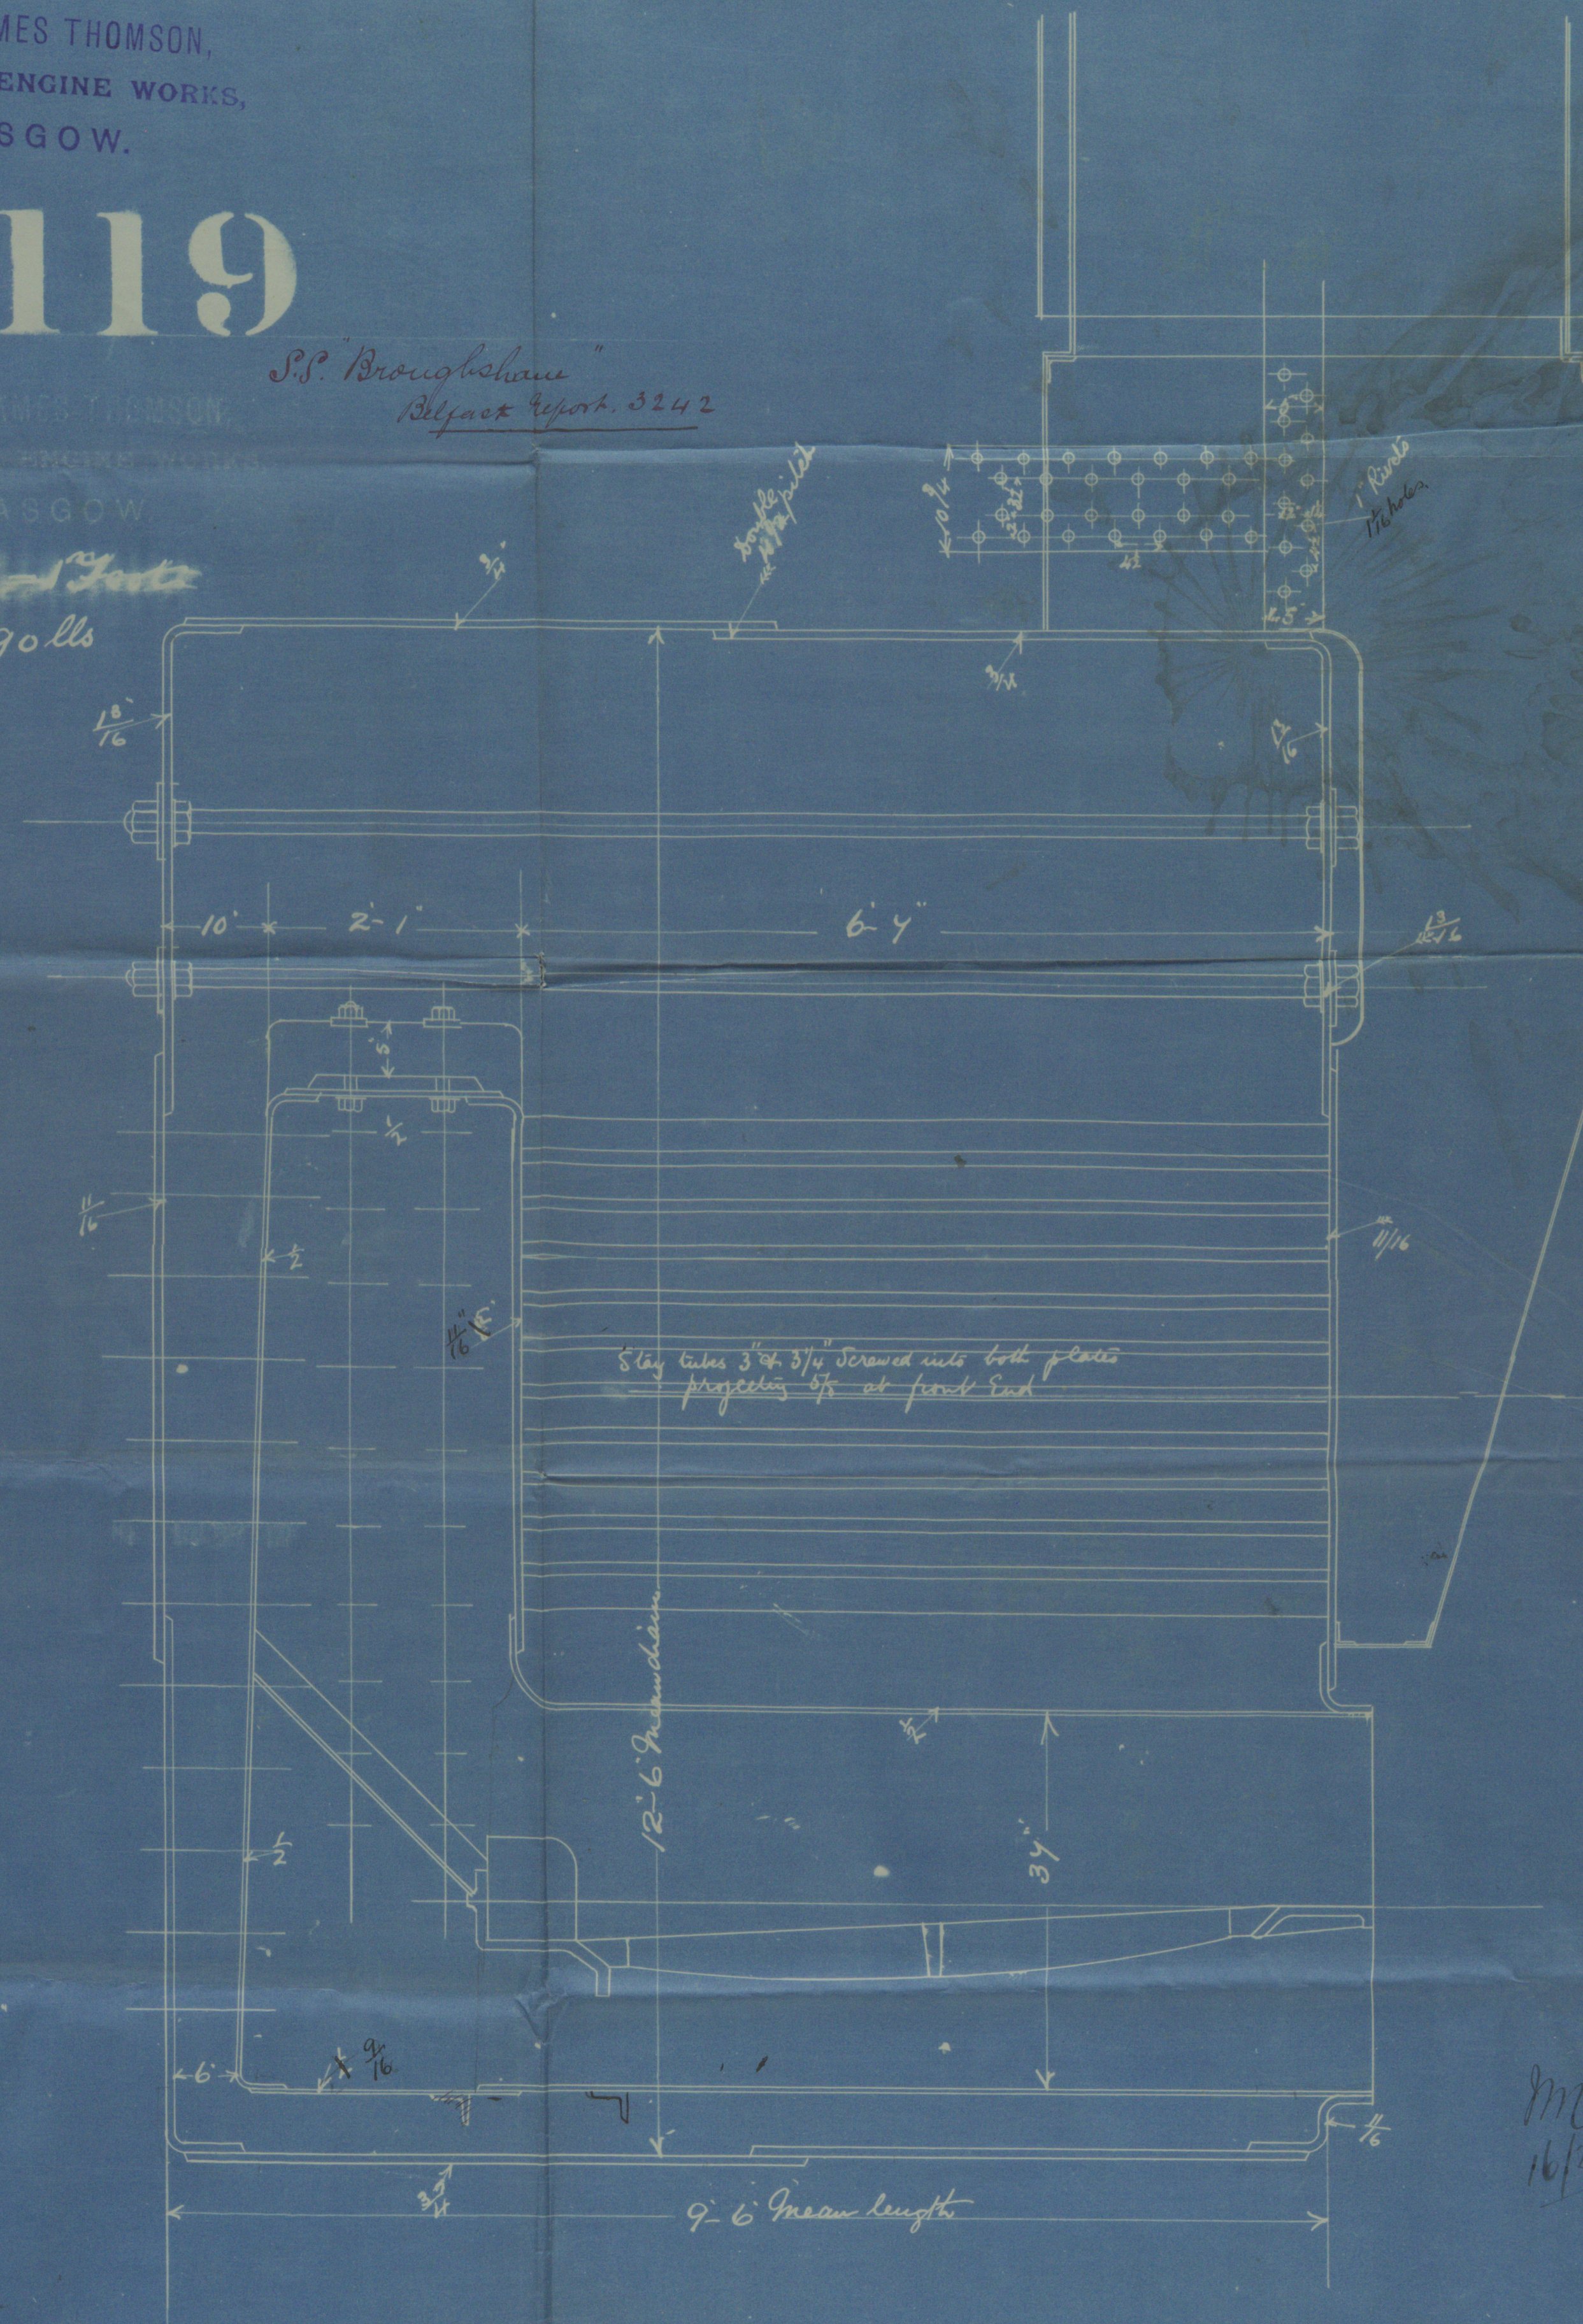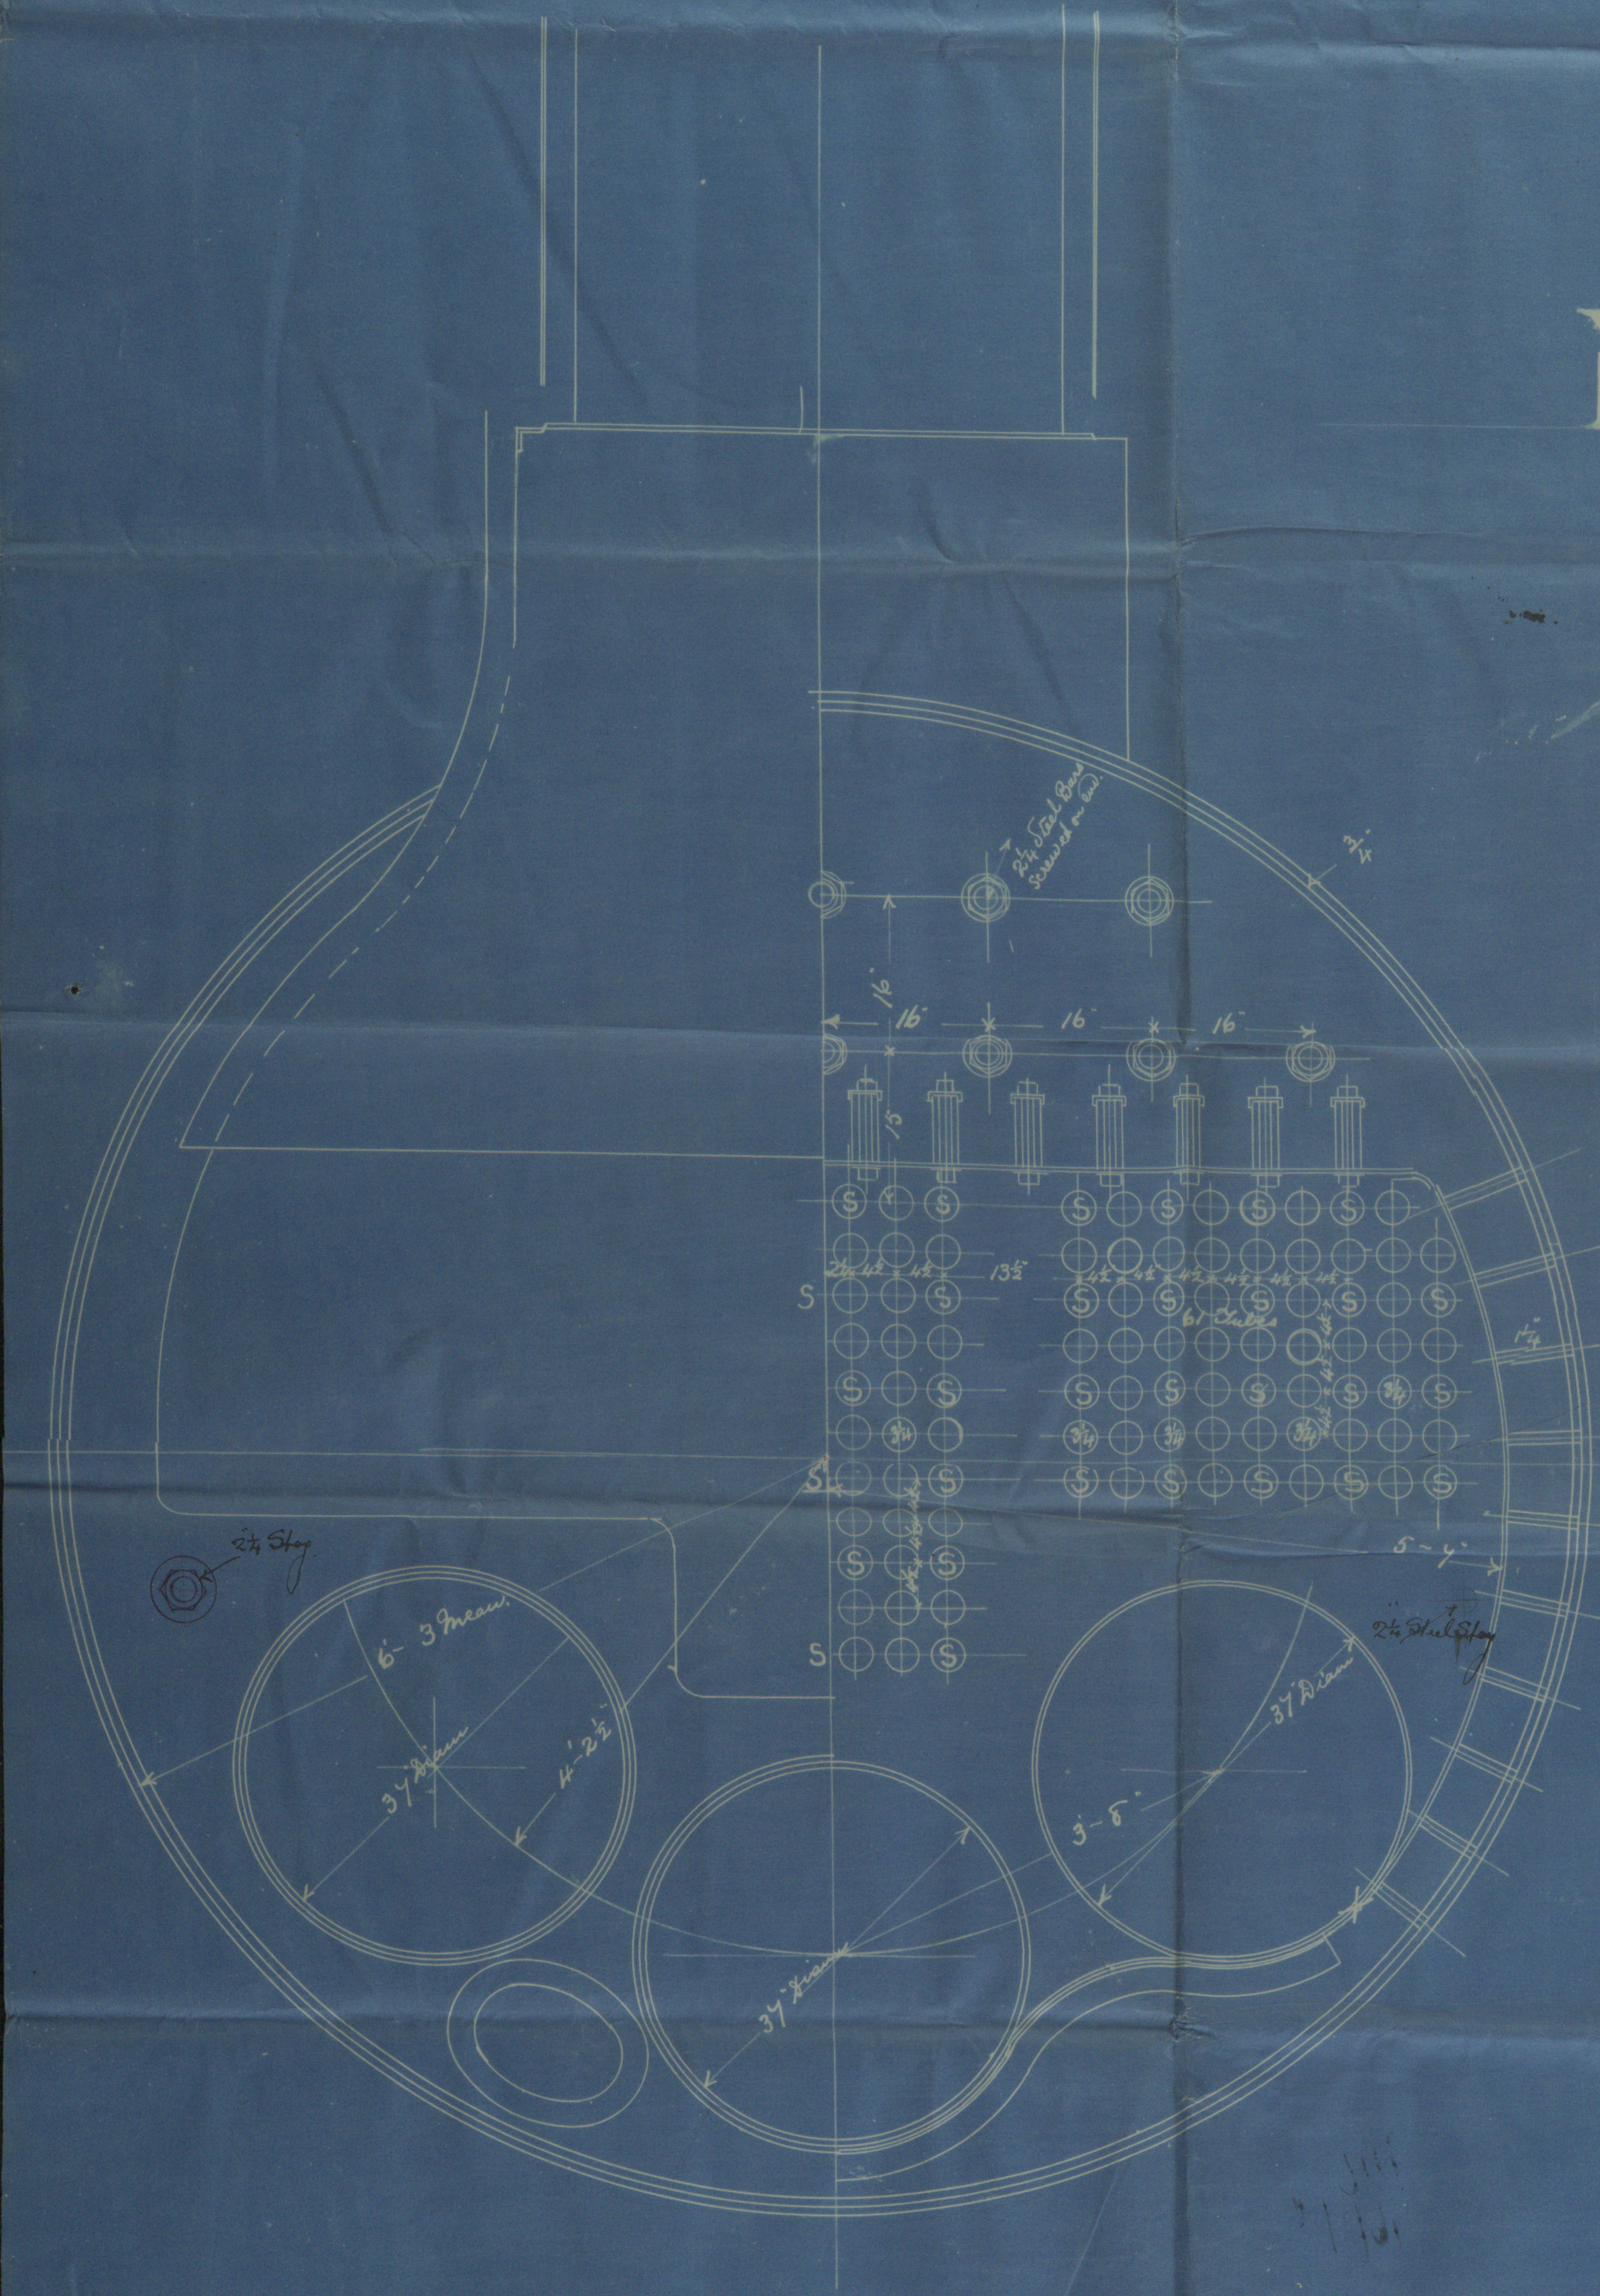

MZ
16/2/86