

Midship Section of 8c 43 Screw Steamer "Broughshane"
To Class 100 A 1 at Lloyds. Belfast Report
No 3242

Dimensions 152' x 23' x 11-10" to floors.

Scale $\frac{1}{2}$ inch = one foot.

Proportions - 6.5 Breadths.

11.6 Depths.


Dimensions - $\frac{1}{2}$ Girth 21.75

$\frac{1}{2}$ Breadth 11.5

Depth 12.91

$$46.16 \times 150.91 = 6.966 \text{ Scantling } 8\text{c} + \frac{1}{10}\text{th}$$

$$7.662 \text{ Equipment } 8\text{c}$$

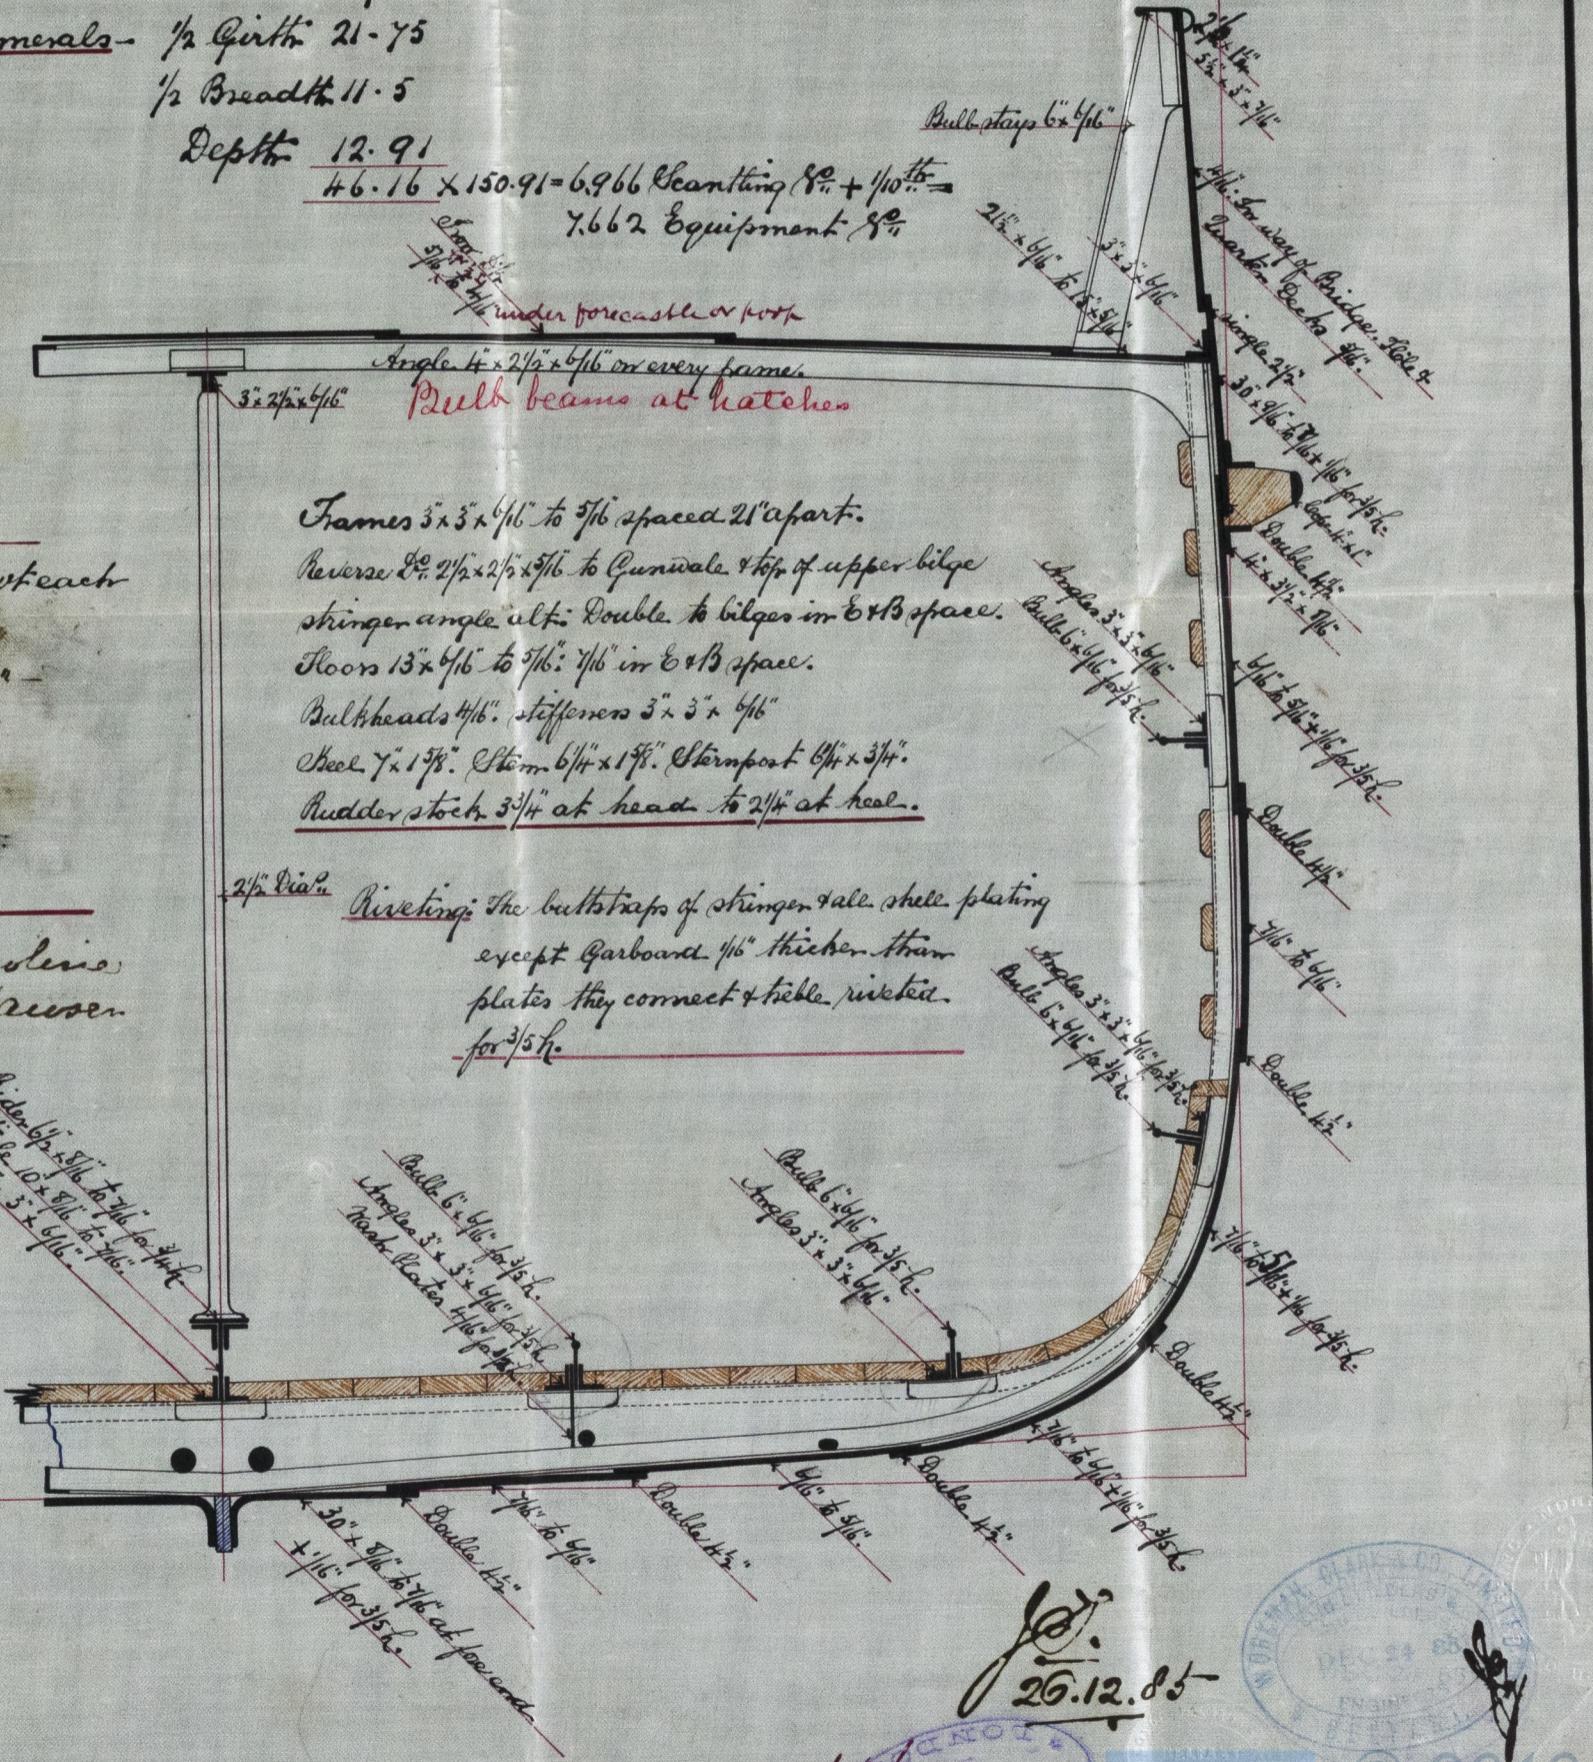

Equipment.

2 Bowers ex stock 8*cwt* each
1 " " " $\frac{1}{2}$
1 Stream " " $2\frac{1}{2}$ "
10 Hedge " " $1\frac{1}{4}$

165 Fathoms $\frac{1}{16}$ " Bower chain.

60. " $\frac{1}{16}$ " Stream "

75 Fathom $\frac{1}{2}$ " Looe line.
90 - " - $\frac{1}{2}$ " Hoveen



29/12/85

NOVEMBER 24 1885
LLOYD'S REGISTER OF SHIPS
LONDON

NOV 24 1885
LLOYD'S REGISTER
OF SHIPS
LONDON

22/12/85

Lloyd's Register
BF453-0302