

BELS3-0377

© 2019

Lloyd's Register  
Foundation





21.8.86.

J. L. Harold  
Belfast Report No 3294


Section at fore end Water Ballast Tank No 44 S.S.

Scale 1/2 inch = one foot.

In After hold only  
Tunnel on top for entire length

Specially stiffened under  
tunnel struts.

Kelsons to be  
stiffened to the  
Surveyor's satisfaction

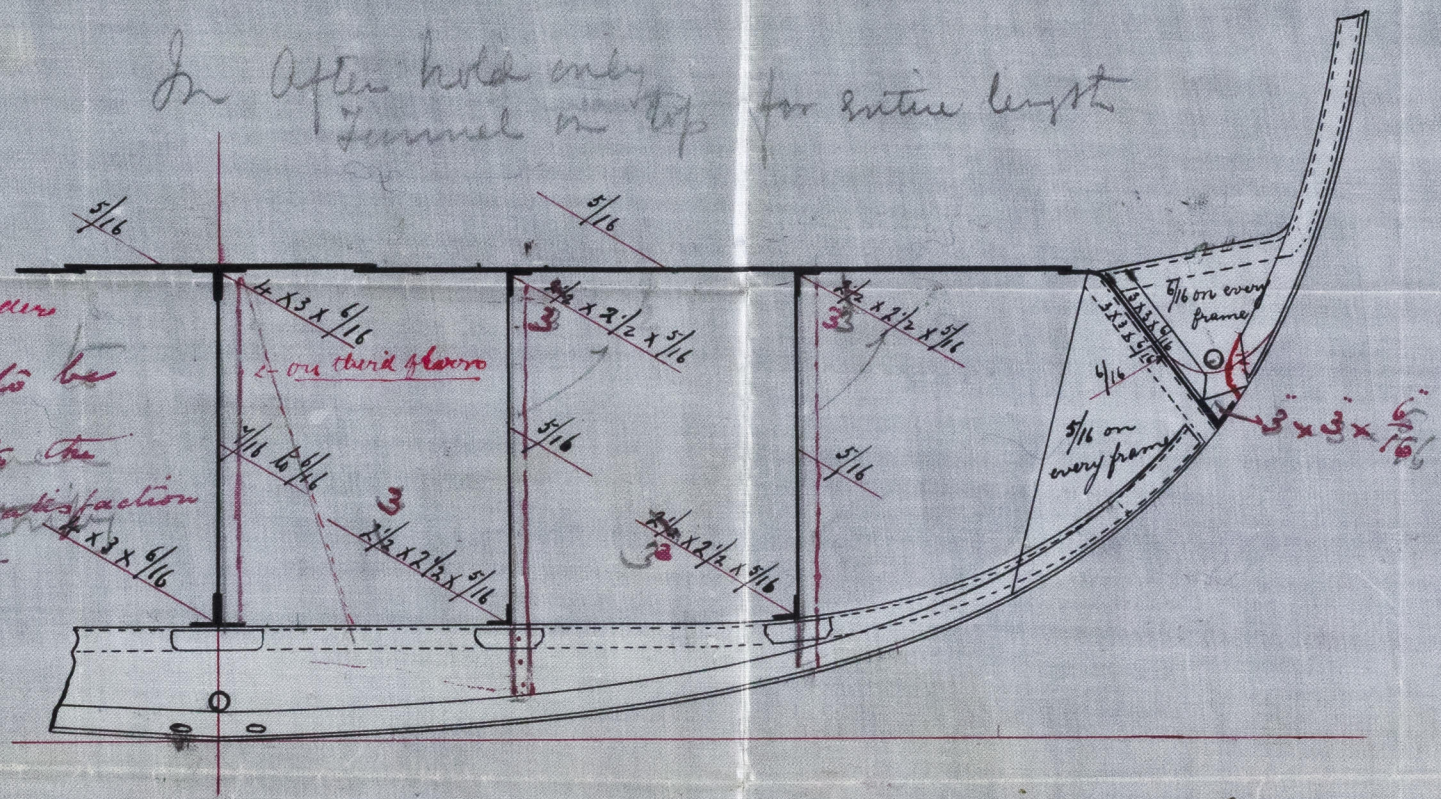

J. L. Harold  
19.8.86



© 2019

Lloyd's Register  
B4493-037A

19.8.86