

J.S. Harold
Belfast Rep. No 294

BEL53-0378




© 2019

Lloyd's Register
Foundation

*Ln to Belfast
5 Jan'y 1897*

Pumping Arrangement No. 44 S. S.

Scale 1/8 inch = one foot

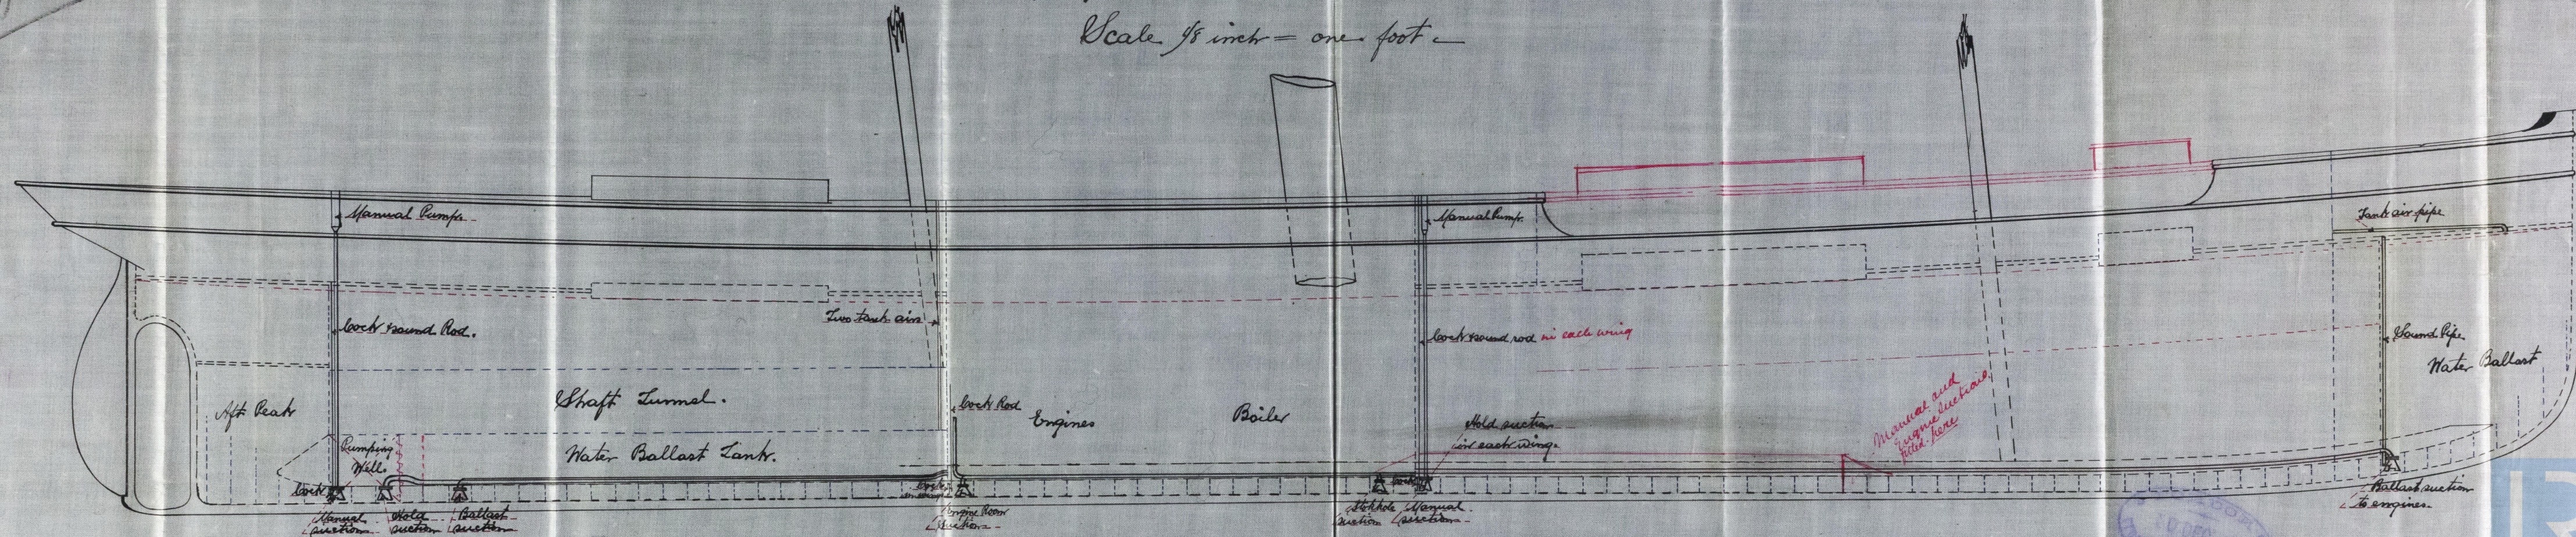

*RECEIVED
BELFAST
TELEGRAPH*

J.M. 17.12.86.

*WORKING COPY & PRINTED
© 2019
BELFAST*

**Lloyd's Register
Foundation**