

499

12

112



S.S. Harold
Belfast Rep. No. 3294

HPCE No. 4

BEL53-0381

21.8.86


21.8.86

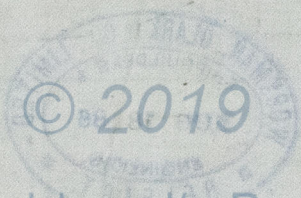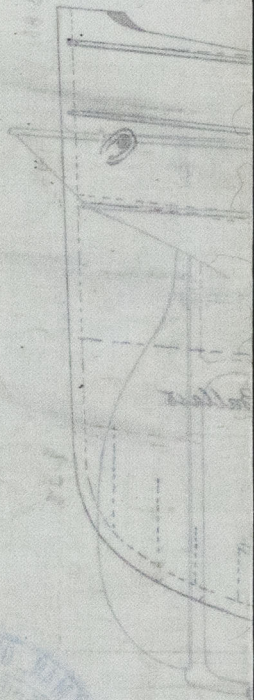

Lloyd's Register
Foundation

21.8.86

21. 8. 87

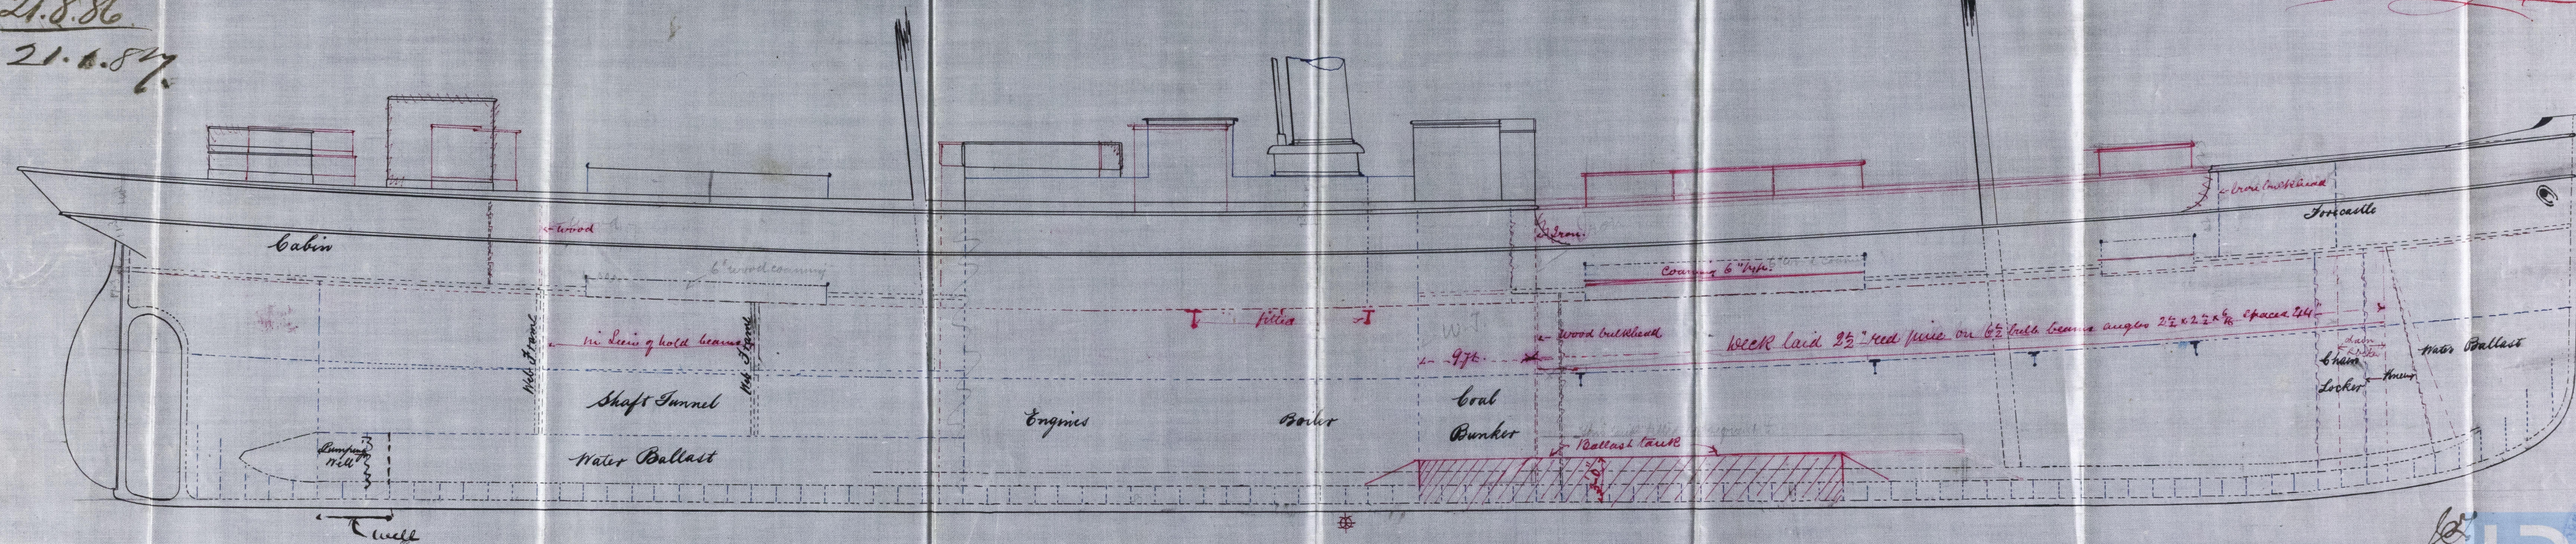

Vessel built in accordance with Red alterations

Am

R. P. Harold
Belfast. Report. No 3294

19. R. 16

19.2.16

Lloyd's Register
Foundation