

Received at Belfast Office, Dec 3rd 1886

Lloyd's Register of British and Foreign Shipping.

(Report on Vessel No. 39 Port Liverpool)

No. _____

SHIP FORGINGS OR CASTINGS.

I have to report that the undermentioned Iron or Steel Forgings or Castings, manufactured by The Mersey Forge Limited of Liverpool for the Vessel No. 39, being built by Messrs Wigham Clark & Co of Belfast have been inspected by me as set forth below, and found to be, so far as can be seen, a good sound forging

Mark on Forgings.

Lloyd's


No. 998

G.A.M.

Geo A Milner
Liverpool.

	STERN FRAME.	RUDDER FRAME.	STEM.
Material* - - - -		<u>Scrap iron</u>	
How made - - - -		<u>Forged</u>	
Dimensions - - - -		<u>Head 9 1/2 diam</u>	
Progress on Inspection -		<u>Finished</u>	
Dates when Inspected		<u>Dec 1st</u>	

SKETCHES OF FRAMES SHEWING POSITION AND DESCRIPTION OF WELDS OF FORGINGS, OR PARTICULARS OF TESTS APPLIED TO CASTINGS.

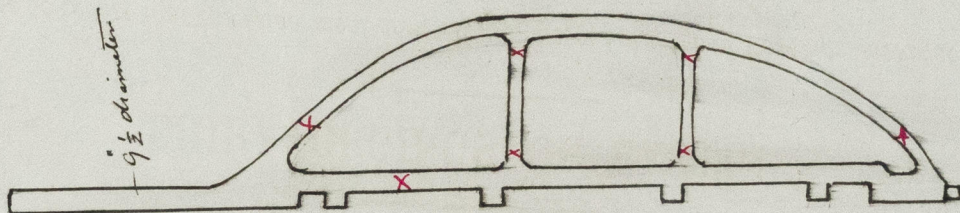

© 2019

Lloyd's Register
Foundation

No 39.
Tings or Castings, Rudder Frame
Dec: 3rd /86

Star of Victoria
Belfast Report
No 3304



© 2019

Lloyd's Register
Foundation