

The words FORGINGS or CASTINGS, IRON or STEEL, should be struck out as may be required.

Received at Belfast Office, June 10th 1885

Lloyd's Register of British and Foreign Shipping.

(Report on Vessel No. 39 Port Liverpool)

No. SHIP FORGINGS OR CASTINGS.

I have to report that the undermentioned Iron or Steel Forgings or Castings, manufactured by

The Messrs Forge & Co of Liverpool
for the Vessel No. 39, being built by Messrs Whitman & Clark
of Belfast have been inspected by me as set forth below, and found
to be, so far as can be seen, a good sound forging

Mark on Forgings.

Lloyd's


No. 974

G.A.M.

Geo A. Milner
Liverpool

	STERN FRAME.	RUDDER FRAME.	STEM.
Material* - - -	<u>Scrap iron</u>		
How made - - -	<u>Forged.</u>		
Dimensions - - -	<u>11" x 7 1/2"</u>		
Progress on Inspection -	<u>Forging & Machining</u>		
Dates when Inspected	<u>April 16th 21st May 4th June 6th</u>		

SKETCHES OF FRAMES SHEWING POSITION AND DESCRIPTION OF WELDS OF FORGINGS, OR PARTICULARS OF TESTS APPLIED TO CASTINGS.

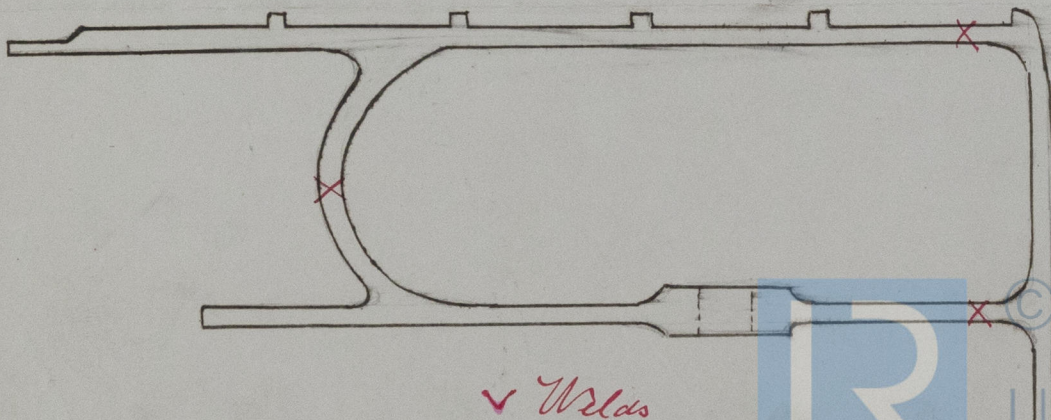

W.C.C.E. No 39
Stem Frame Forging
"Star of Victoria"
Belfast Report
No 3304



© 2019

Lloyd's Register
Foundation