


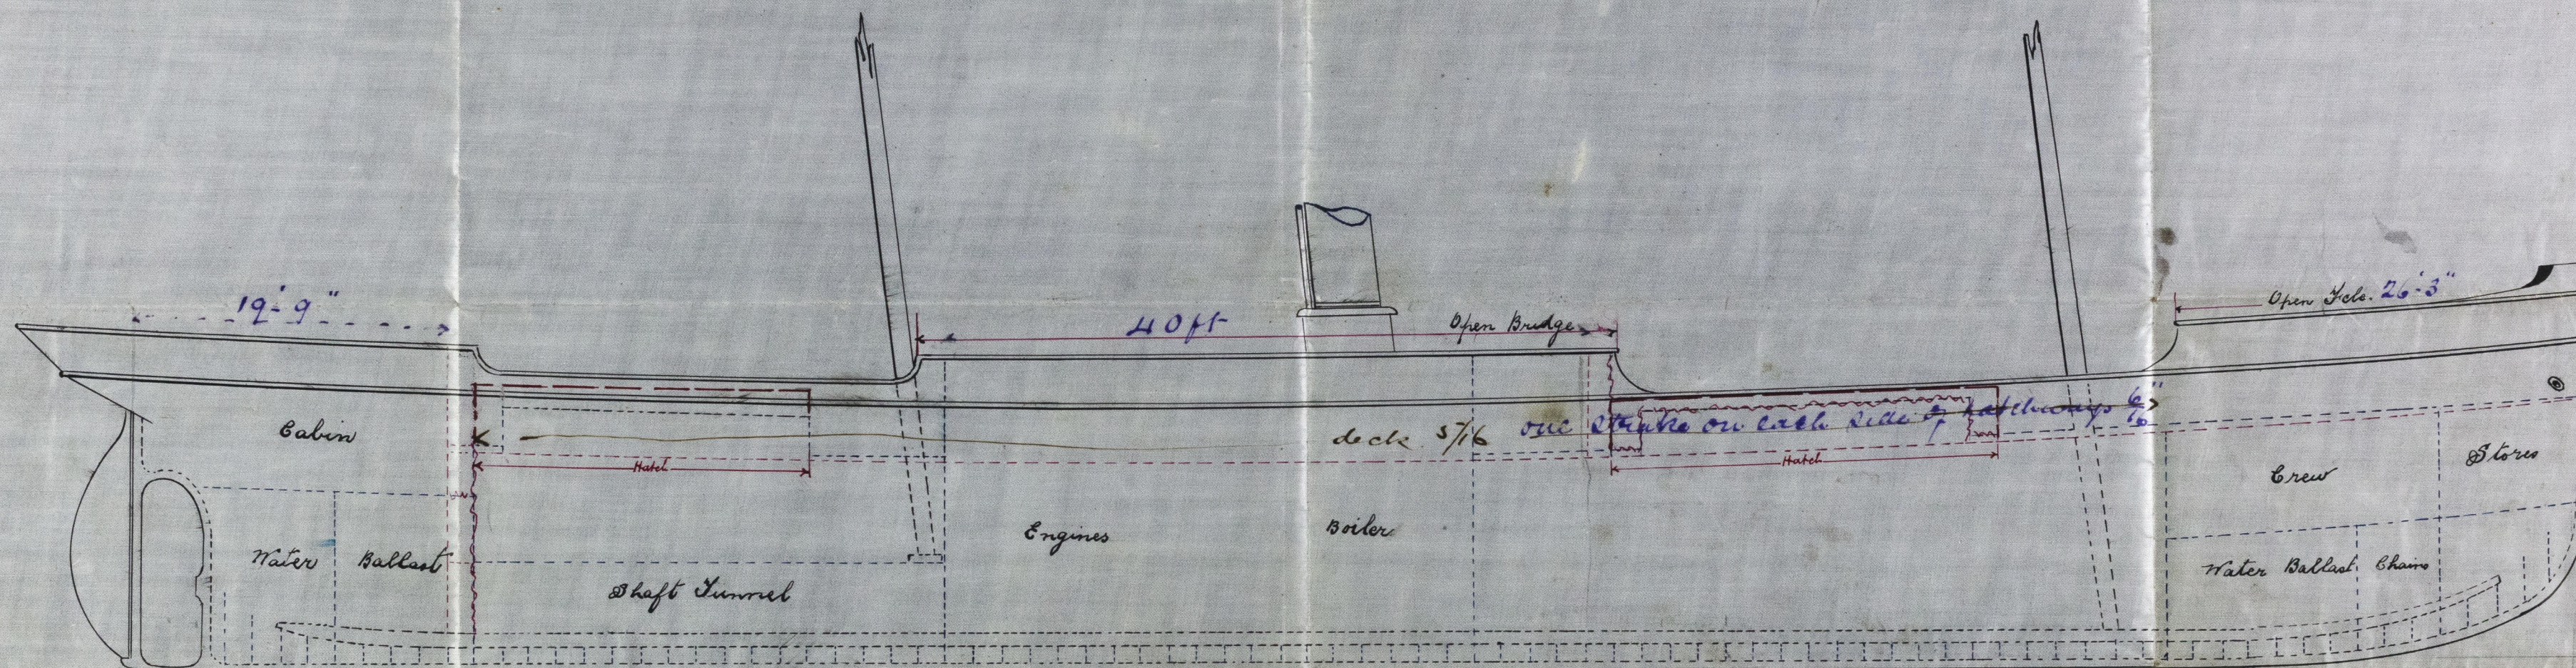

25.10.86

Profile No 45. S. S. "Kathleen" Bel. Report. No 3312.

Scale 1/8" inch = one foot.



23.10.86



© 2019

Lloyd's Register Foundation

BE754-0064