


Dimensions 155'-6" x 23' x 11'-11"

To class 100 A. 1

Scale  $\frac{1}{2}'' = \text{one foot}$

Numerals  $\frac{1}{2}$  Girth 21.57 Proportions Breadths 6.7  
 $\frac{1}{2}$  Breadth 11.5 Depths 11.8  
 Depth  $\frac{13.0}{46.37 \times 154.45 = 7,161}$  Scantling 40.

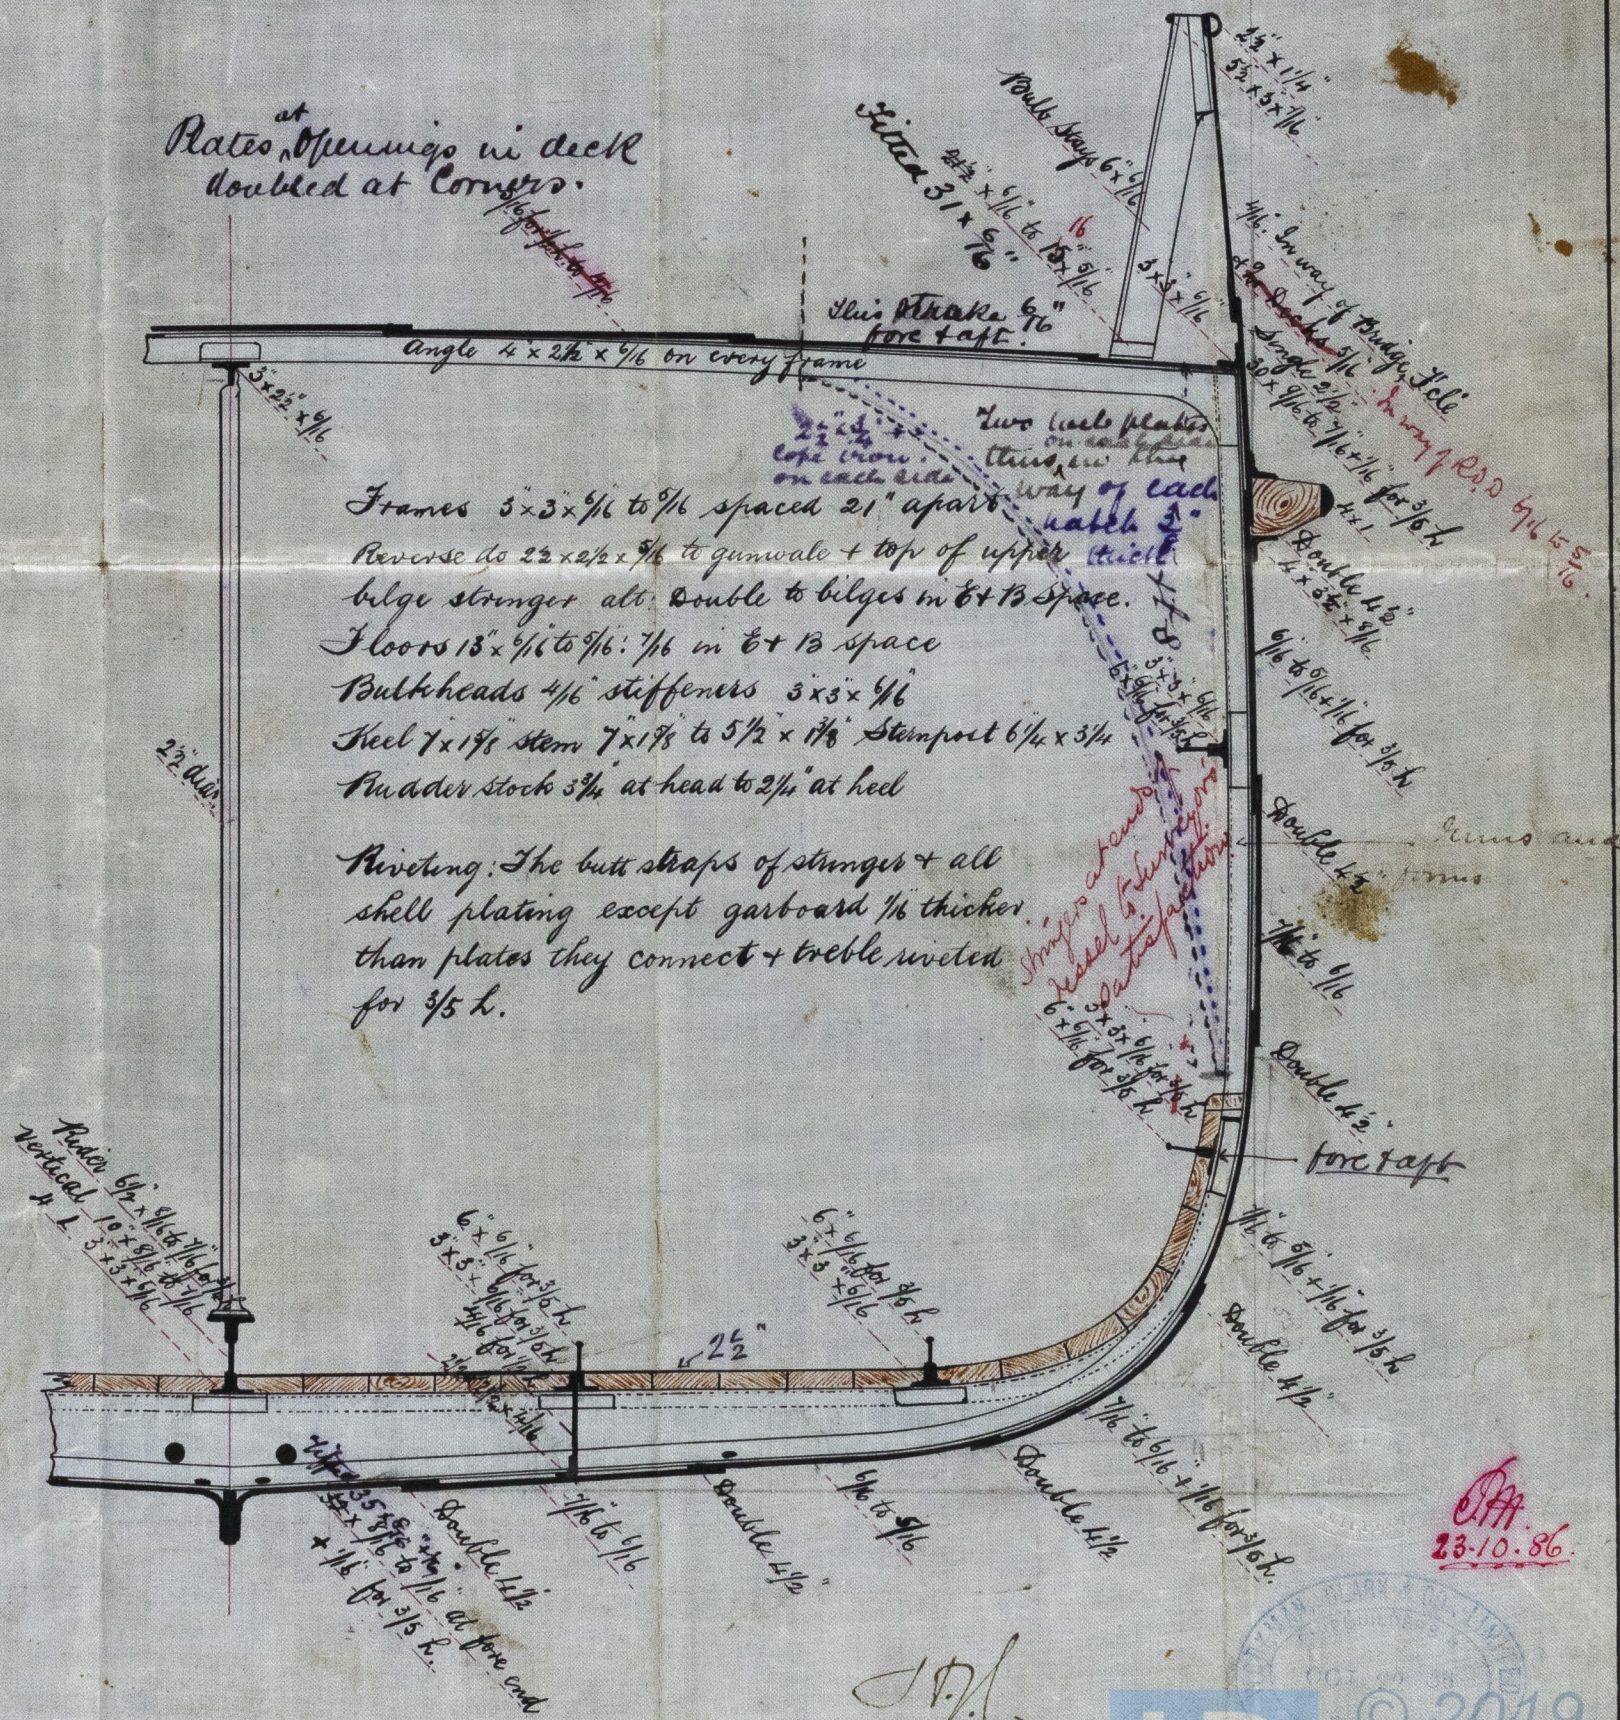

23-10.86

J.D.L.  
25/10/86



© 2019

Lloyd's Register  
Foundation