


Let to Belfast  
5 January 1887

Pumping Arrangement 8<sup>th</sup> 45 S. S. 'Kathleen'. Belfast Report No 3312  
Scale 1/8 inch = one foot.

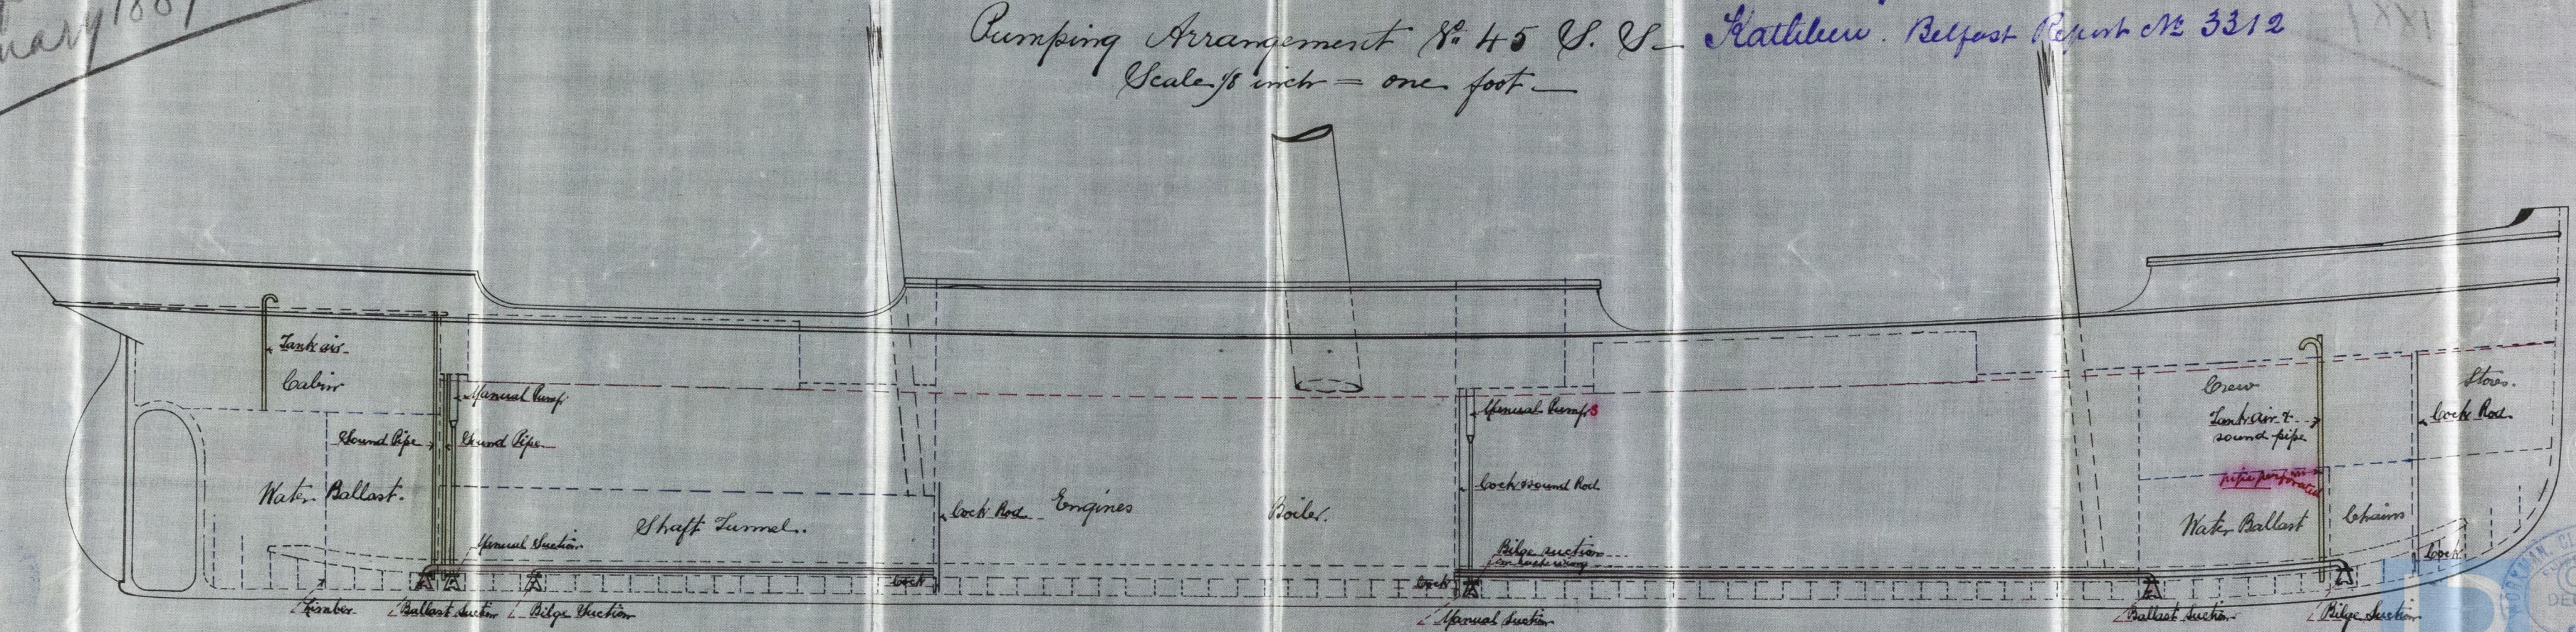

AM. 17.12.86  
© 2019  
DEC 15 86  
Belfast's Register  
Foundation  
BEL54-0067