


Lts. to Bel
5/1/87

Pipe Arrangement 8" x 5 U. S.
Scale 1/4 inch = one foot

S.S. "Kathleen"
Belfast Report No 3312

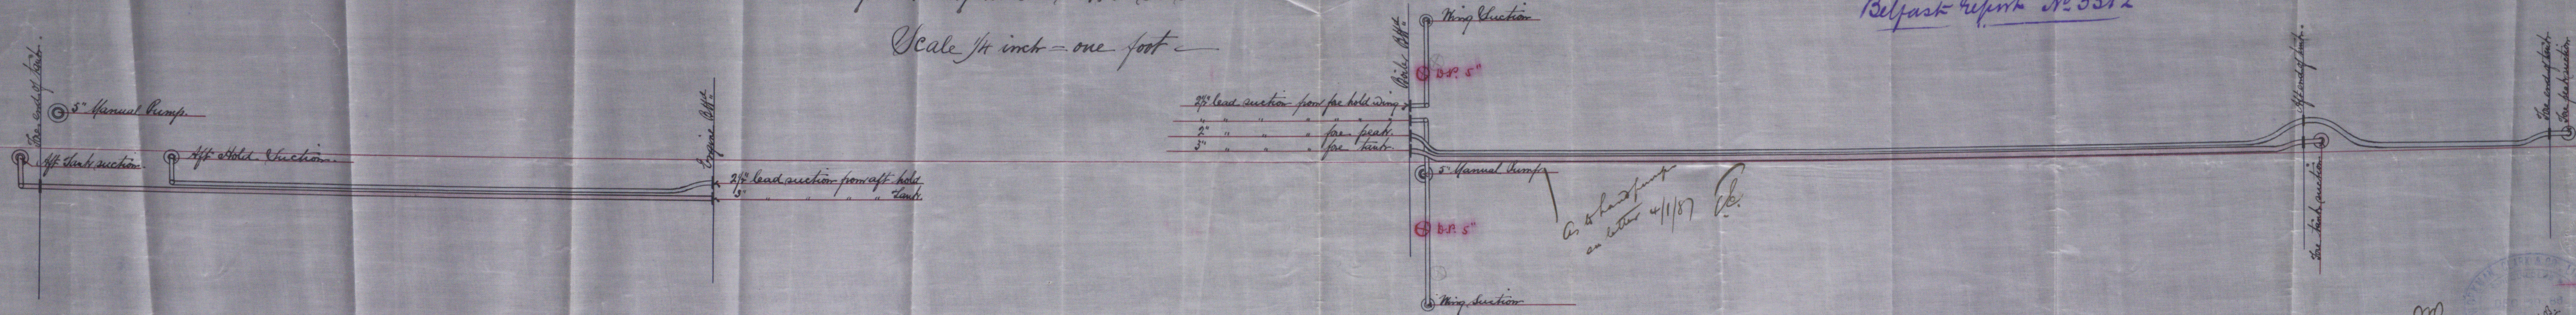

mm
3.1.87



© 2019

Lloyd's Register
Foundation