

The words FORGINGS or CASTINGS, IRON or STEEL, should be struck out as may be required.

Received at

Belfast

Office,

OCT 26 18 87



# Lloyd's Register of British and Foreign Shipping.

(Report on Vessel No. 204 Port Belfast)

No. 612 a

## SHIP FORGINGS OR CASTINGS.

I have to report that the undermentioned Iron or Steel Forgings or Castings, manufactured by  
The Darlington Forge Co- of Darlington  
for the Vessel No. 204, being built by Messrs Harland & Wolff  
of Belfast have been inspected by me as set forth below, and found  
to be, so far as can be seen, sound.

Mark on Forgings.

Lloyd's

No. 612 a


No. 6.

Hugh Cameron

Sunderland  
24/10/87

|                          | STERN FRAME. Port                     | RUDDER FRAME.   | STEM.    |
|--------------------------|---------------------------------------|---|----------|
| Material* - - -          | Scrap iron                            | Scrap iron  |          |
| How made - - -           | Forged                                | Forged  |          |
| Dimensions - - -         | 9' x 3 3/8                            | 4 1/2 - 3 3/4   |          |
| Progress on Inspection - | Forged Smithed                        | Forged Smithed  | Not seen |
| Dates when Inspected     | May 3-6-13-18-23-24<br>June 2-7-10/87 | Aug 2-4-13-18-24-27-31<br>Sept 4-16-21-26-28 Oct 3-7/87 |          |

SKETCHES OF FRAMES SHEWING POSITION AND DESCRIPTION OF WELDS OF FORGINGS, OR PARTICULARS OF TESTS APPLIED TO CASTINGS.

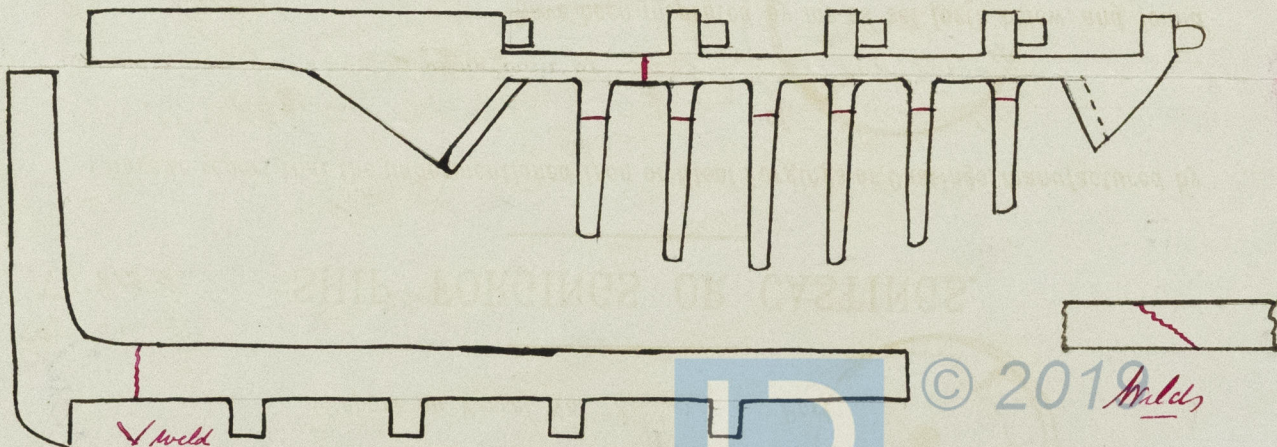



Id & Ws No 204  
Stem post - & Rudders  
frames.

---

*India*  
Belfast Report  
No 3091



© 2019

Lloyd's Register  
Foundation