

The words FORGINGS or CASTINGS, IRON or STEEL, should be struck out as may be required.

*Belfast*

Received at *Belfast* Office, *8<sup>th</sup> Nov.* 18*84*

# Lloyd's Register of British and Foreign Shipping.

(Report on Vessel No. *3399* Port *Belfast* )

## No. *525a*. SHIP FORGINGS OR CASTINGS.

I have to report that the undermentioned Iron ~~or Steel~~ Forgings ~~or Castings~~, manufactured by *The Darlington Forge Co* of *Darlington* for the Vessel No. *49*, being built by *Messrs Workman Clark & Co* of *Belfast* have been inspected by me as set forth below, and found to be, so far as can be seen, *sound*.


Mark on Forgings.

Lloyd's  
No. *525a*  
*H.C.*

*Henry Cameron*  
*Sanduland*  
*4/11/84*

	STERN FRAME.	RUDDER FRAME.	STEM.
Material*	<i>Scrap iron</i>	<i>Scrap iron</i>	
How made	<i>Fayed</i>	<i>Fayed</i>	
Dimensions	<i>11" x 7 1/2"</i>	<i>9 1/2" - 11 1/2"</i>	
Progress on Inspection	<i>Fayed Smithed</i>	<i>Fayed Smithed</i>	
Dates when Inspected	<i>Jan 26-27 Feb 4-11-14-19-26</i> <i>March 2-6-9-11/84</i>	<i>Aug 31 Sept 4-16-21-26-28</i> <i>Oct 3-4-13-17-22 Nov 1-5/84</i>	

SKETCHES OF FRAMES SHEWING POSITION AND DESCRIPTION OF WELDS OF FORGINGS, OR PARTICULARS OF TESTS APPLIED TO CASTINGS.

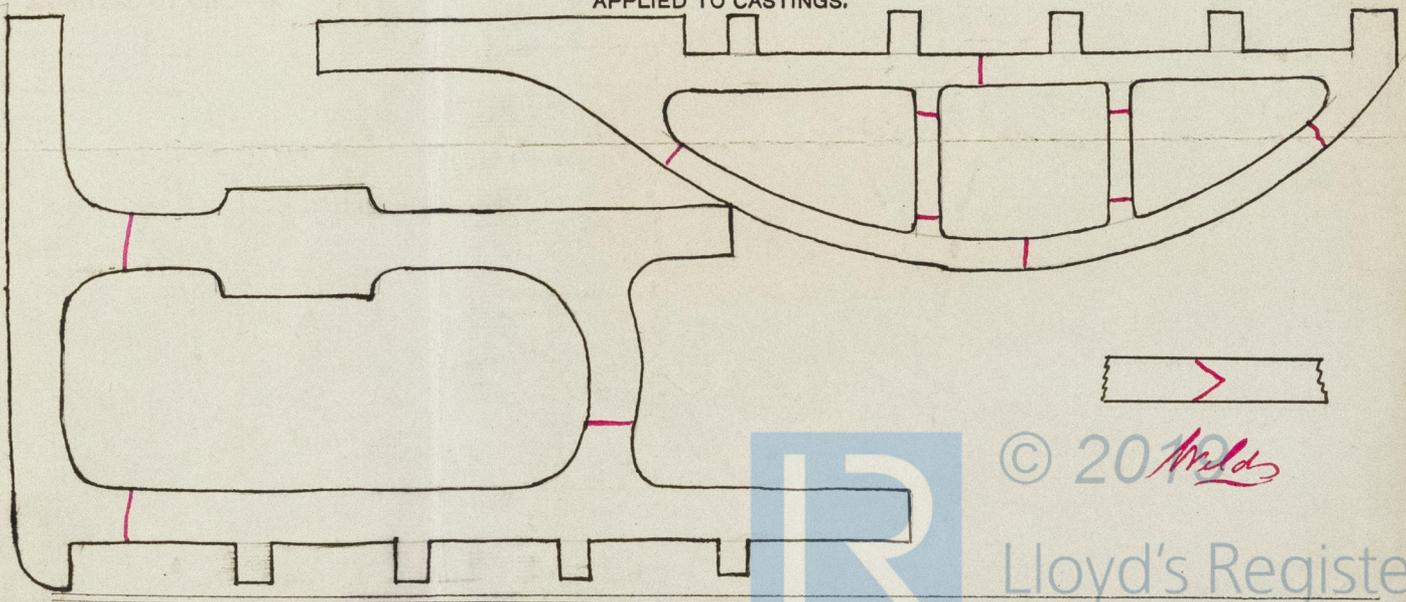

© 2012 *Mids*

Lloyd's Register  
Foundation

\* If of Iron, state whether scrap or puddled iron.

*S.S. City of Dublin*  
*Belfast Rep. No 3399.*

*Workman & Clarke's*  
*49*  
*Blair & Rudder Peame*



© 2019

Lloyd's Register  
Foundation