

LLOYD'S REGISTER OF SHIPPING
19 APR. 86
LONDON


19.4.86.

M
19/4/86

Plan Showing Bulkheads &
Pumping Arrangement No 39 S.S. -
Scale 1/2 inch = one foot. -


M
19/4/86

Star of Victoria
Belfast Report on Freeboards No. 3300
S.S. City of Dublin Belfast Rep. No. 3399
(see minute copy).

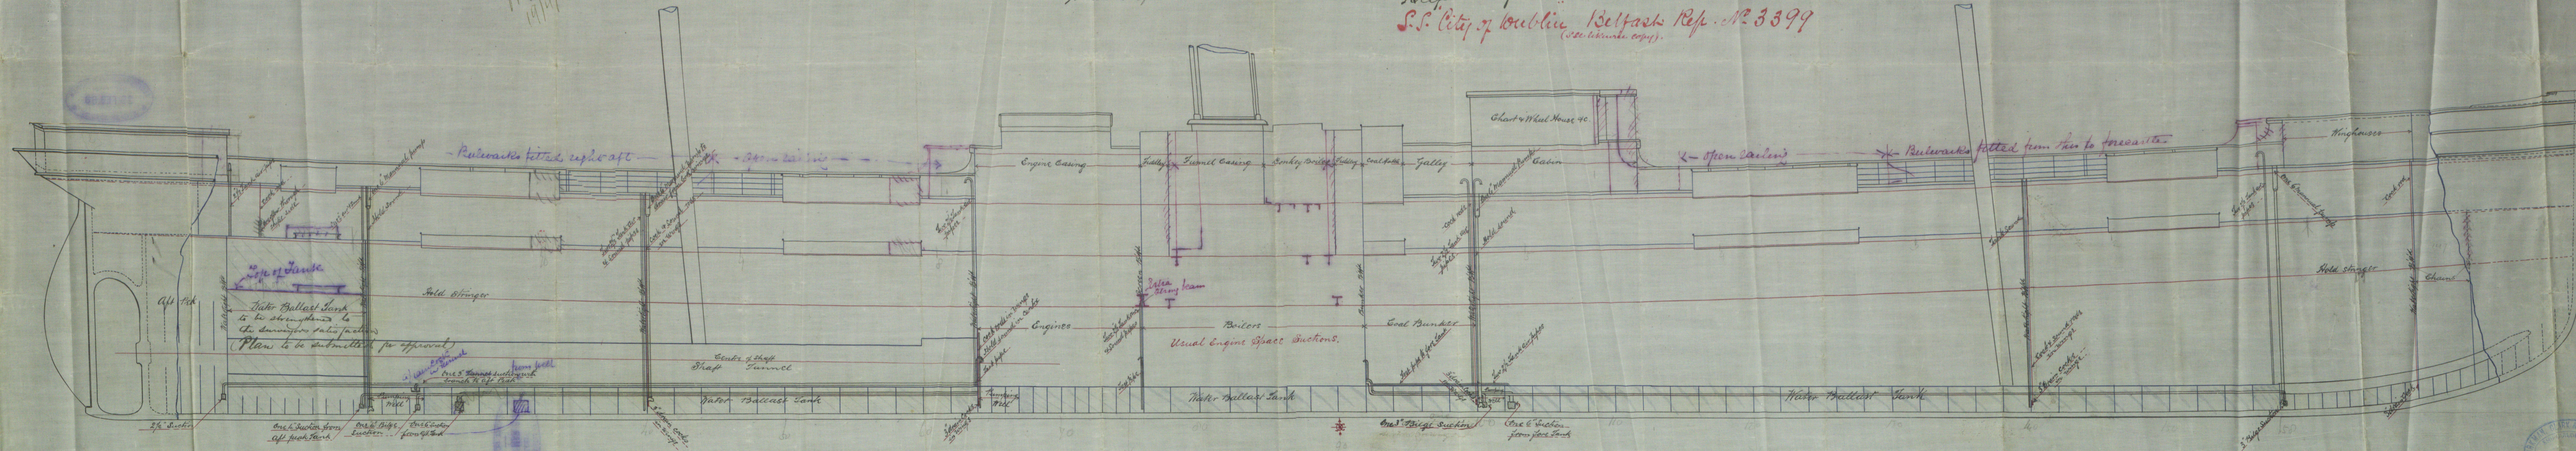


ALFRED PARK & CO. LIMITED
17-4-86
1870
17.4.86

Lloyd's Register
Foundation

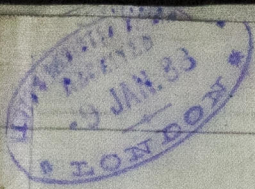

18. H. 81

BEL54-0193

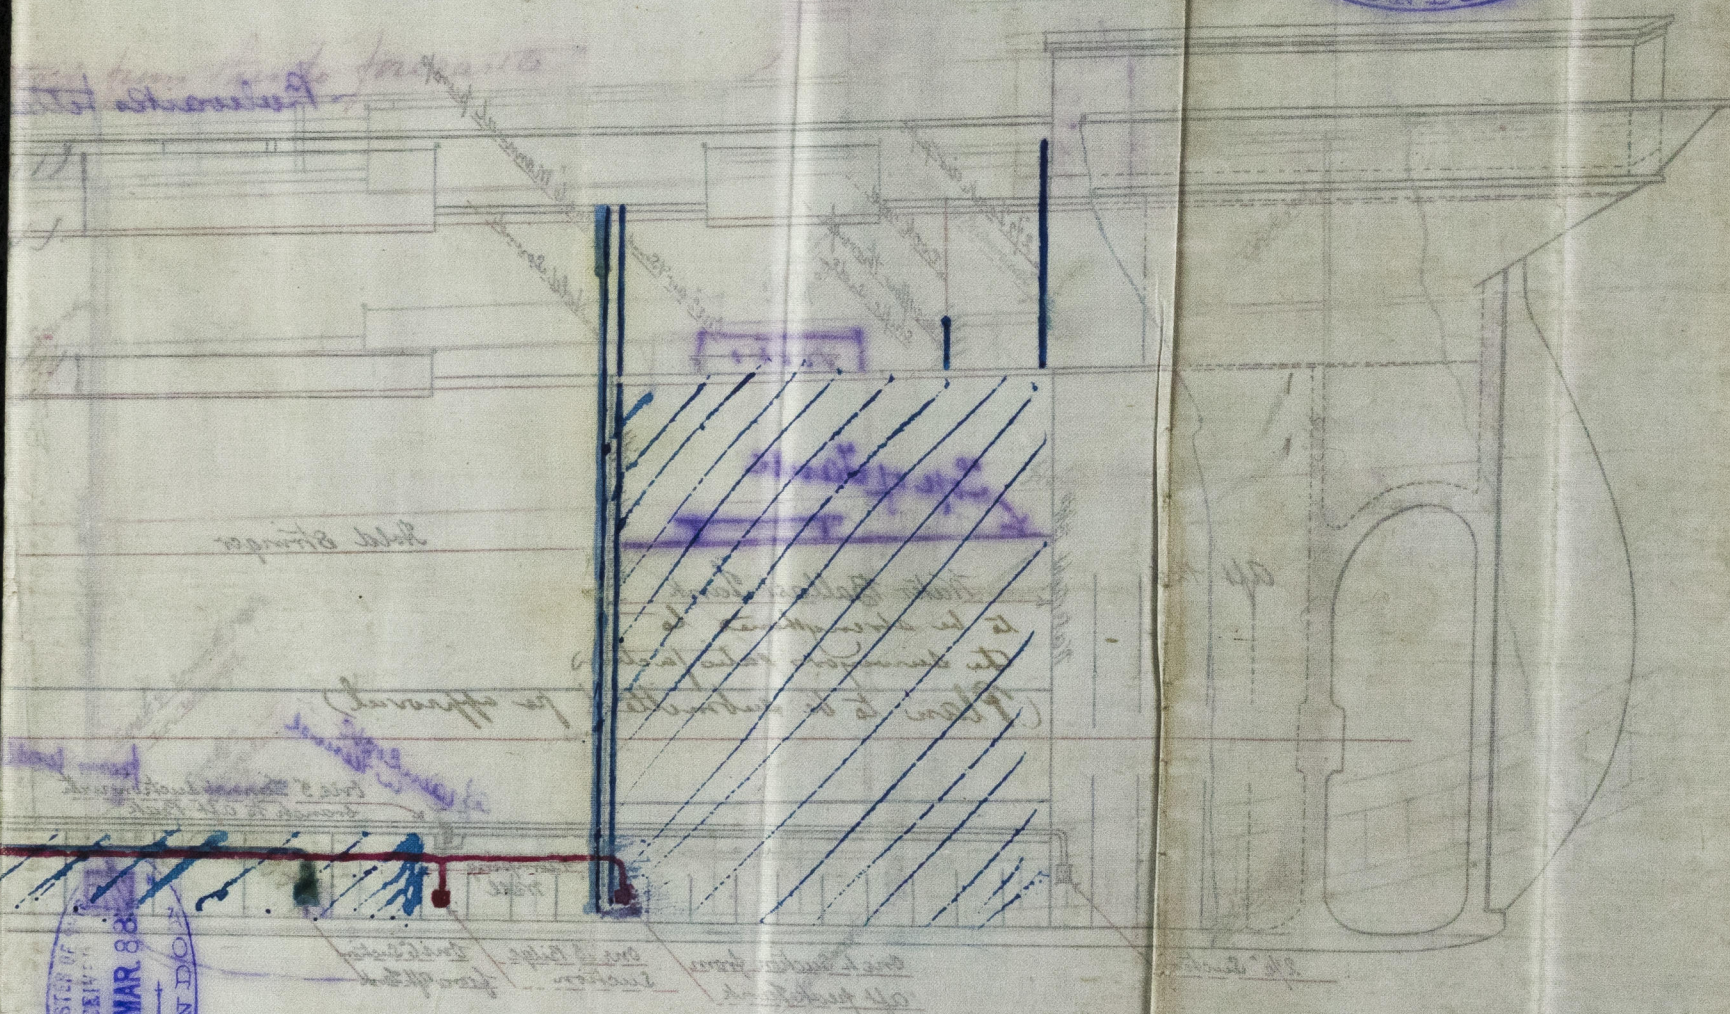

© 2019

Lloyd's Register Foundation