

The words FORGINGS or CASTINGS, IRON or STEEL, shall be struck out as may be required.

Belfast

Q. 1. 8d

1st Number

97.29

Owners O. & J. S.

Received at *Belfast* Office. *No. 47* 18 *84*

Lloyd's Register of British and Foreign Shipping.

(Report on Vessel No. _____ Port *Belfast*)

No. *649A* SHIP FORGINGS OR CASTINGS.

I have to report that the undermentioned Iron or ~~Steel~~ Forgings or Castings, manufactured by *The Darlington Forge Co.* of *Darlington* for the Vessel No. *205*, being built by *Messrs. Rowland Wolff* of *Belfast* have been inspected by me as set forth below, and found to be, so far as can be seen, *sound*.

Mark on Forgings.


Lloyd's
No. *649A*
to C.

Hugh Cameron

Sunduland
2/11/84

	STERN FRAME. <i>Port</i>	RUDDER FRAME.	STEM.
Material	<i>Scrap iron</i>	<i>Scrap iron</i>	<i>Scrap iron</i>
Finish	<i>Faced</i>	<i>Faced</i>	<i>Faced</i>
Dimensions	<i>9" x 3 3/8"</i>	<i>7 1/2" - 3 3/4"</i>	<i>9" x 3 3/8"</i>
Condition on Inspection	<i>Faced & Smithed</i>	<i>Faced & Smithed</i>	<i>Faced</i>
Inspected	<i>July 16-21-27-29 Aug 2/84</i>	<i>Aug 2-9-13-18-24-31 Sept 7-16 21-26-28 Oct 13-17-22 Nov 1/84</i>	<i>July 12/84</i>

PLANS OF FRAMES SHEWING POSITION AND DESCRIPTION OF WELDS OF FORGINGS, OR PARTICULARS OF TESTS APPLIED TO CASTINGS.

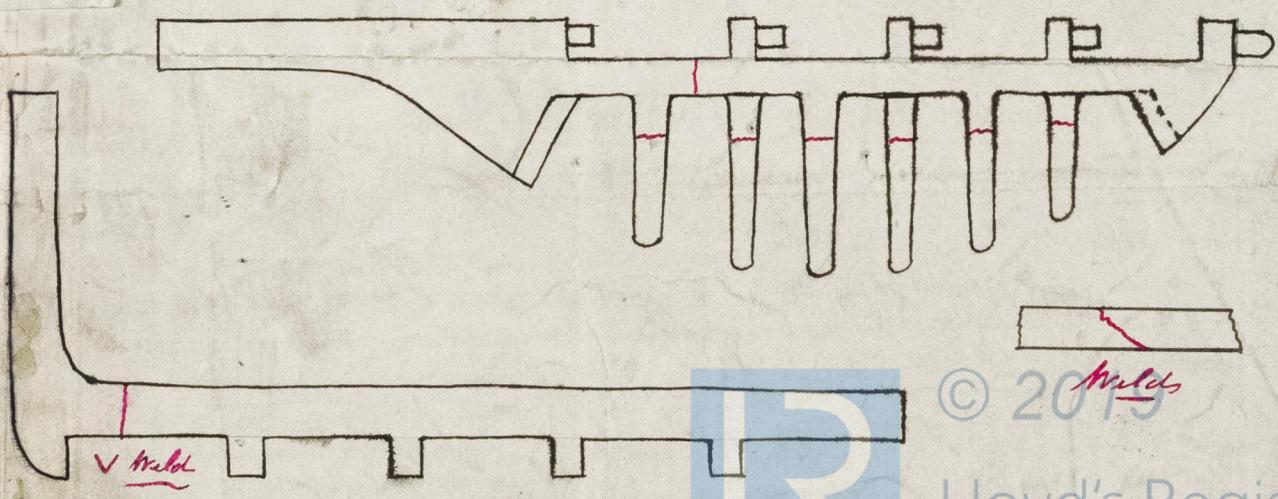

* If of Iron, state whether scrap or puddled iron.

[T-2000-10/83-Trans. Ink.]

649



© 2015

Lloyd's Register Foundation

BELSH-0251

Butt Straps of Keelsons, Stringer and Tie Plates, Keelsons, Tie, and Stringer Plates, Outside Plating, &c.?

Harland & Wolffs No. 206.
Stern post, Rudder
frame and stem forgings

"Holkar"
Belfast Report
No. 34201



© 2019

Lloyd's Register
Foundation