


Tracing No. 11.


20.1.87.

S. S. "Titanic"
Belfast Report No. 3422.

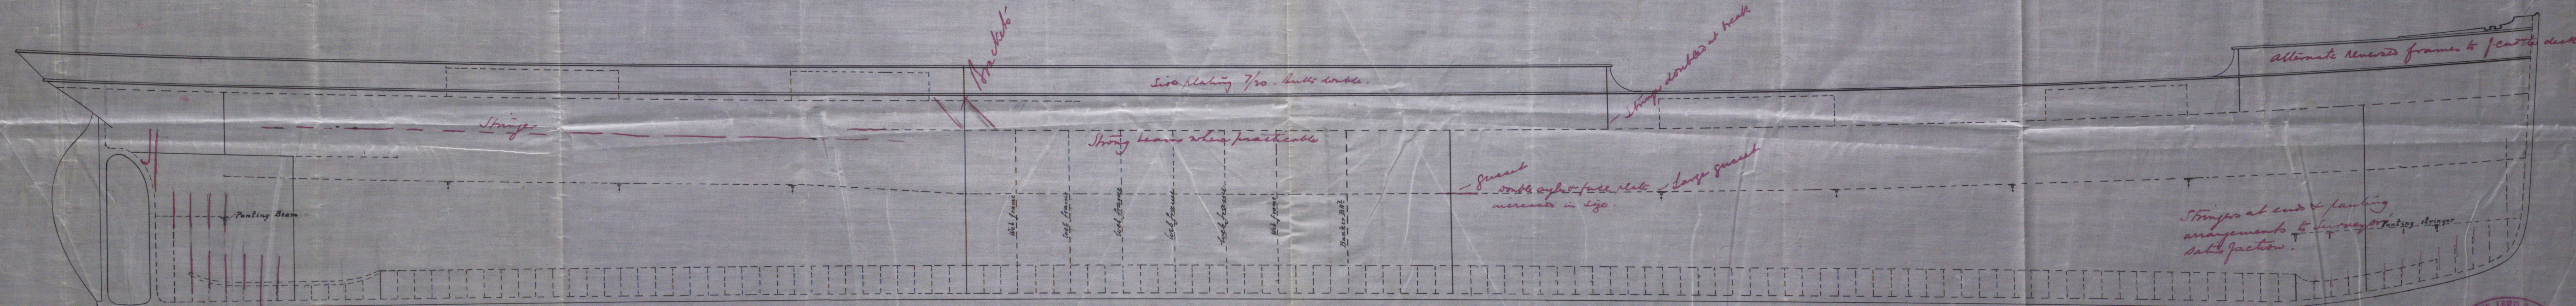

S. S. No. 28. Profile.

Scale 1/8" = 1 foot

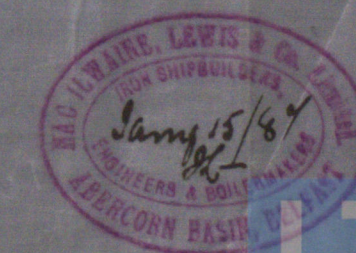

Lloyd's Register
Foundation